

SUNFLOWER

M 41

12/4/79

MISSISSIPPI BOARD OF WATER COMMISSIONERS
416 North State Street
Jackson, Mississippi 39201

CODED

WATER WELL DRILLERS LOG

12/4 1979 DYER WELL FIRM SUNFLOWER
date well completed firm name county well located

LANDOWNER:

HOLLY RIDGE

INDIANOLA
(mailing address)

description of formations encountered

from

to

Clay 0 23
fine sand 23 35
sand 35 48
sand & gravel 48 113

WELL LOCATION:

sec. 20 T 19 N R 5 E
4 miles N E of HOLLY RIDGE
(distance) (direction) (nearest town)

WELL PURPOSE:

(home, irrigation, municipal, industrial)

WELL COMPLETION DATA:

- (1) diameter (inches) 16"
- (2) total depth (feet) 113
- (3) static water level (feet) 22 (below) above top of ground.
- (4) casing STEEL 73 (material) (depth)
16 (size) if telescope see back.
- (5) screen 40 73 (length) (depth to top)
16 STEEL (size) (material)
- (6) pump 40 180 0 (HP) (yield gpm)
DIESEL (type power)
- (7) electric log NO (yes or no)

(organization running log)

(8) how well bottom plugged STEEL PLATE

DRILLERS REMARKS:

CODED


DEPT. OF NATURAL RESOURCES
BUREAU OF LAND & WATER RESOURCES

OCT 14 1980

RECEIVED

If well telescopes please sketch and show depths.

GROUND LEVEL

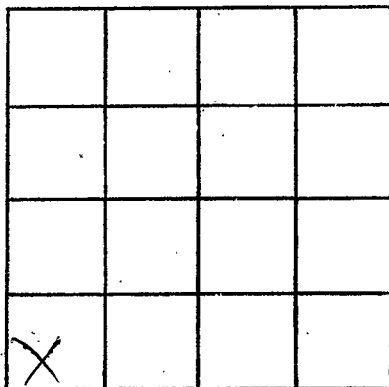

SECTION 20

Please indicate well location X.

ADDITIONAL INFORMATION

If more than one screen, show locations of each on sketch.