

SUNFLOWER
M 43
4-28-81

MISSISSIPPI DEPARTMENT OF NATURAL RESOURCES
Bureau of Land and Water Resources
Southport Mall
P.O. Box 10631
Jackson, Mississippi 39209
WATER WELL DRILLERS LOG

CODED

4/28/81 date well completed
Dyer Well Co. Inc. firm name
Sunflower county well located

LANDOWNER: Bobby Joe Sykes

description of formations encountered	from	to
fine sand	0	38
sand	38	56
Sand & Gravel	56	85
fine sand	85	94
Sand & Gravel	94	133

CODED

Indianola, Ms.
(mailing address)

WELL LOCATION:
sec. 12 T. 19 N. R. 5 E. S. 4 W.
4 miles N of Holly Ridge
(distance) (direction) (nearest town)

WELL PURPOSE:
(home, irrigation, municipal, industrial)

WELL COMPLETION DATA:

- (1) diameter (inches) 16"
- (2) total depth (feet) 133'
- (3) static water level (feet) 20' below top of ground.
- (4) casing Steel 133' (material) (depth)
16" (size) if telescope see back.
- (5) screen 40' 93' (length) (depth to top)
16" (size) Steel (material)
- (6) pump 40 2000 (HP) (yield gpm)
Mopac (type power)
- (7) electric log NO (yes or no)
- (organization running log)
- (8) how well bottom plugged plate

DRILLERS REMARKS:


DEPT. OF NATURAL RESOURCES
BUREAU OF LAND & WATER RESOURCES

MAY 19 1981

RECEIVED

If well telescopes please sketch and show depths.

GROUND LEVEL

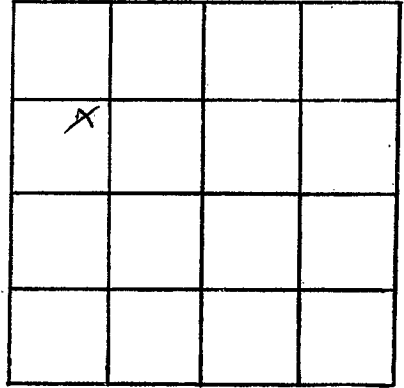

SECTION 17

Please indicate well location X.

ADDITIONAL INFORMATION

If more than one screen,
show locations of each on sketch.