

MISSISSIPPI DEPARTMENT OF NATURAL RESOURCES

Bureau of Land and Water Resources

Southport Mall

P.O. Box 10631

0049

Jackson, Mississippi 39209

WATER WELL DRILLERS LOG CODED

Sun Flower  
M 44  
2-10-81

2/10/81  
date well completed

Dyer  
firm name

Sun  
county well located

LANDOWNER:  
HOLLY RIDGE, MS  
Rabuton Bras  
(mailing address)

description of formations encountered

from

to

Clay	0	30
Fine sand	30	41
Sand	41	59
Sand & gravel	59	113

WELL LOCATION:  
sec 20 T 19 N R 5 E  
2 miles N of Holly Ridge  
(distance) (direction) (nearest town)

WELL PURPOSES:  
(home, irrigation, municipal, industrial)

CODED

WELL COMPLETION DATA:

(1) diameter (inches) 16

(2) total depth (foot) 113'

(3) static water level (foot) 18' <sup>20'</sup> below top of ground.

(4) casing STEEL 73'  
(material) (depth)

16" if telescope see back.  
(size)

(5) screen 40 7.3  
(length) (depth to top)

16" Steel  
(size) (material)


(6) pump 60 3000  
(HP) (yield, gpm)

Diesel  
(type power)


(7) electric log (yes or no)

(organization running log)

(8) how well bottom plugged date

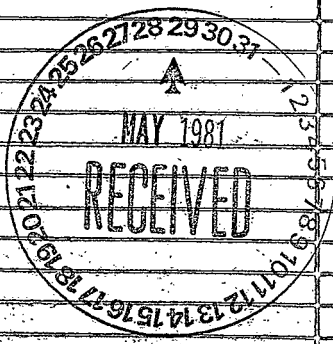

DRILLERS REMARKS:

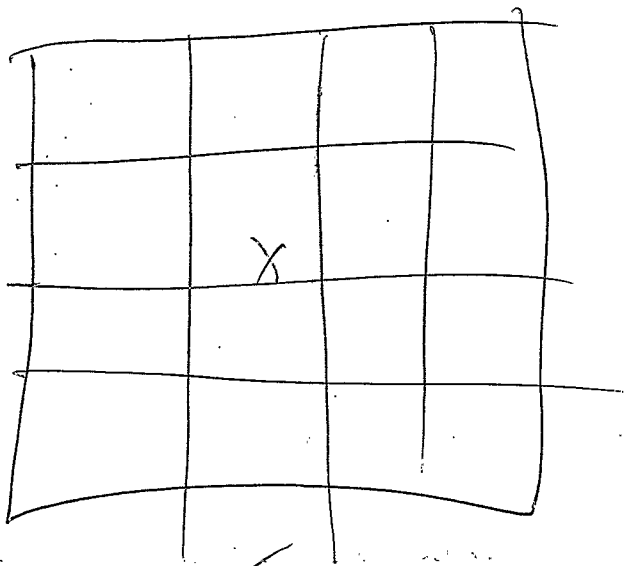

Sec 18