

MISSISSIPPI DEPARTMENT OF NATURAL RESOURCES

Bureau of Land and Water Resources

Southport Mall

P.O. Box 10631

Jackson, Mississippi 39209

WATER WELL DRILLERS LOG CODED

Sanflower  
M45  
2-9-81

0045

2/9  
date well completed

Dyll  
firm name

Sum.  
county well located

LANDOWNER:

BI. SYKES

description of formations encountered

from

to

Holly Ridge, MS.  
(mailing address)

<u>Clay</u>	<u>0</u>	<u>26</u>
<u>fine sand</u>	<u>26</u>	<u>38</u>
<u>sand</u>	<u>38</u>	<u>68</u>
<u>glnd + gravel</u>	<u>68</u>	<u>93</u>

WELL LOCATION:

sec. 18 T. 19 S. R. 5 E.  
4 miles N of Holly Ridge  
(distance) (direction) (nearest town)

WELL PURPOSE:

(home, irrigation, municipal, industrial)

WELL COMPLETION DATA:


- diameter (inches) 12
- total depth (feet) 93'
- static water level (feet) 20' below top of ground.
- casing Steel, 93'  
(material) (depth)  
12"  
(size) If telescopic see back.
- screen 40', 53'  
(length) (depth to top)  
12", Steel  
(size) (material)
- pump 40, 2000  
(HP) (yield gpm)  
Prop  
(type pump)
- electric log (yes or no)


CODED

(organization running log)

(8) how well bottom plugged plate

DRILLERS REMARKS:

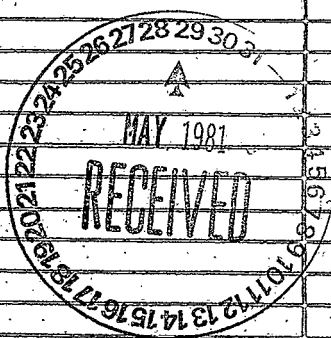

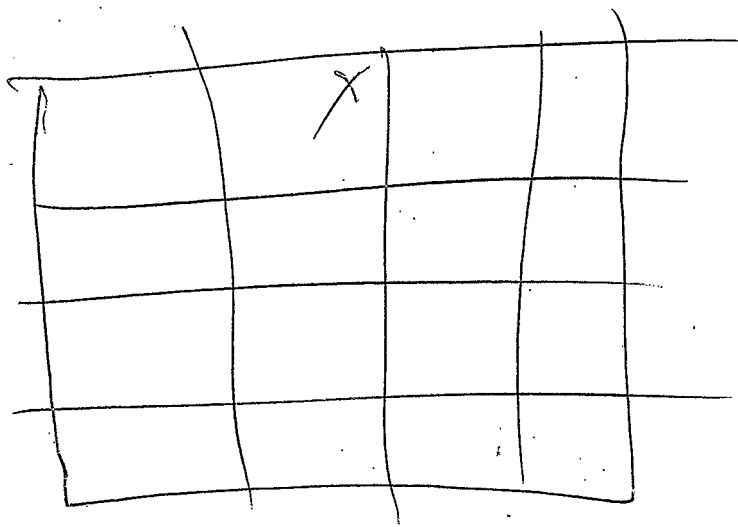

See 18