

Bureau of Land and Water Resources

Southport Mall

P.O. Box 10631

Jackson, Mississippi 39209

WATER WELL DRILLERS LOG

0061
CODED

Sunflower
M46
2-10-81

2/16 19 81 date well completed
Dyer firm name
Sun county well located

LANDOWNER:
Burke Fisher
Holly Ridge, MS.
(mailing address)

description of formations encountered	from	to
Clay	0	32
Fine sand	32	48
Sand	48	64
Sand + Gravel	64	110


WELL LOCATION:
sec. 18 T. 19 S. R. 5 E.
4 miles N of Holly Ridge
(distance) (direction) (nearest town)

WELL PURPOSES:
(home, irrigation, municipal, industrial)

CODED

WELL COMPLETION DATA:

- (1) diameter (inches) 16"
- (2) total depth (feet) 110'
- (3) static water level (feet) 20' below top of ground.
- (4) casing Steel 110' (material) (depth)
16" (size) If telescopic see back.
- (5) screen 40' 70' (length) (depth to top)
16" (size) Steel (material)
- (6) pump 60 3000 (HP) (yield gpm)
Diesel (type power)

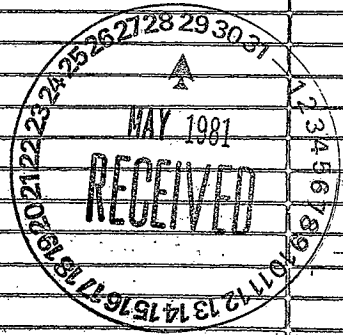


(7) electric log (yes or no)

(organization running log)

(8) how well bottom plugged plate

DRILLERS REMARKS:

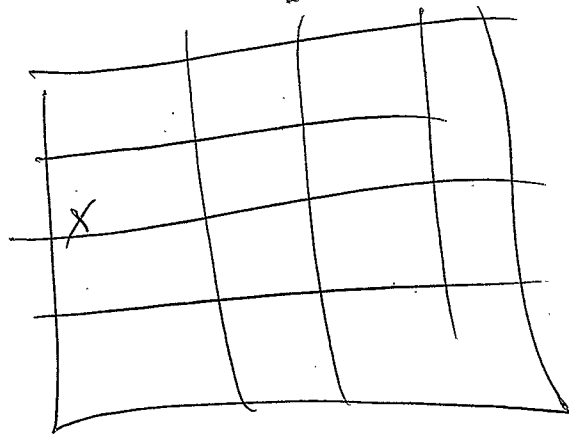

Sec 18