

Sunflower
M47
3-4-80

MISSISSIPPI
BOARD OF WATER COMMISSIONERS
416 North State Street
Jackson, Mississippi 39201

CODED

WATER WELL DRILLERS LOG

3/4

19 80

Dyer

Sun

date well completed

firm name

county well located

LANDOWNER:

BILLUPS PLTN

INDIANOLA, MS.

(mailing address)

description of formations encountered

from

to

Clay	0	28
Fine Sand	28	39
Sand	39	38
Sand & Gravel	38	123

WELL LOCATION:

sec. 33 T 18 N

R. 5 E

3

miles

W

of

Indianola

(distance)

(direction)

(nearest town)


WELL PURPOSE:

(home, irrigation, municipal, industrial)

WELL COMPLETION DATA:

- diameter (inches) 16"
- total depth (feet) 113'
- static water level (feet) 21' below top of ground.
- casing Steel 113' (material) (depth)
16" (size) if telescope see back.
- screen 40' 73' (length) (depth to top)
16" (size) Steel (material)
- pump 60 3000 (HP) (yield gpm)
elective (type power)
- electric log (yes or no)
- how well bottom plugged plate

CODED

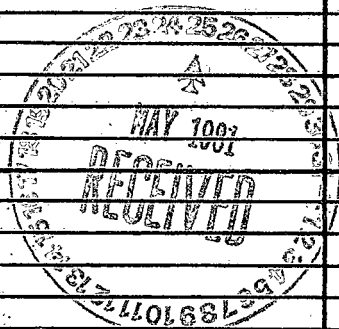

DRILLERS REMARKS:

