

SUNFLOWER
M 48
6-4-81

MISSISSIPPI DEPARTMENT OF NATURAL RESOURCES
Bureau of Land and Water Resources
Southport Mall
P.O. Box 10631
Jackson, Mississippi 39209
WATER WELL DRILLERS LOG

CODED

6-4 19 81 date well completed
Dyer Well & Irrigation firm name
Sunflower county well located

LANDOWNER: Frank Fisher
Oscharla, MS.
(mailing address)
WELL LOCATION:
sec. 19 T. 19 (N) S R. 5 E (W)
3 miles N of Hollyhock
(distance) (direction) (nearest town)

description of formations encountered	from	to
clay	0	22
fine sand	22	38
clay	38	48
fine sand	48	64
sand & gravel	64	92

WELL PURPOSE:
(home, irrigation, municipal, industrial)

- WELL COMPLETION DATA:
- (1) diameter (inches) 16"
 - (2) total depth (feet) 92'
 - (3) static water level (feet) 21' below above top of ground.
 - (4) casing steel 92'
(material) (depth)
16" if telescope see back.
(size)
 - (5) screen 30' 62'
(length) (depth to top)
16" steel
(size) (material)
 - (6) pump 60 3000
(HP) (yield gpm)
Diesel
(type power)
 - (7) electric log _____
(yes or no)

(organization running log)
 - (8) how well bottom plugged plate

CODED

DEPT. OF NATURAL RESOURCES
BUREAU OF LAND & WATER RESOURCES


JUN 15 1981

RECEIVED

DRILLERS REMARKS:

If well telescopes please sketch and show depths.

GROUND LEVEL

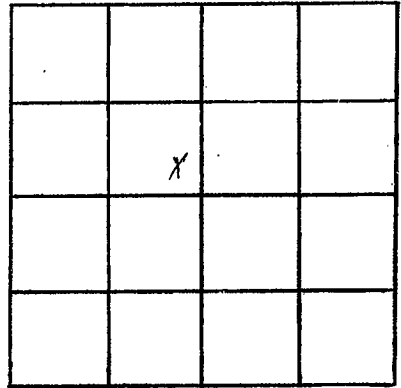

SECTION 19

Please indicate well location X.

ADDITIONAL INFORMATION

If more than one screen,
show locations of each on sketch.