

MISSISSIPPI DEPARTMENT OF NATURAL RESOURCES

Bureau of Land and Water Resources

Southport Mall

P.O. Box 10631

Jackson, Mississippi 39209

WATER WELL DRILLERS LOG

CODED

Sample  
M49  
5-21-81

May 21 1981 Larry's well & pump Sample  
 date well completed firm name county well located

LANDOWNER: <u>William Pitts</u>	description of formations encountered	from	to
<u>Indiana, Miss</u> (mailing address)			
	<u>Loose Sand</u>	<u>28</u>	<u>50</u>
	<u>Coarse Sand</u>	<u>50</u>	<u>93</u>

WELL LOCATION:  
 sec. 34 T. 19 N. R. 5  
9 miles NW of Indiana  
 (distance) (direction) (nearest town)

WELL PURPOSE:  
 (home, irrigation, municipal, industrial)

WELL COMPLETION DATA:

(1) diameter (inches) 10"

(2) total depth (feet) 93'

(3) static water level (feet) 22 below above top of ground.

(4) casing Steel, 53',  
 (material) (depth)  
 (size) if telescope see back.

(5) screen 40', 53'  
 (length) (depth to top)  
10", Steel  
 (size) (material)

(6) pump 10 700  
 (HP) (yield gpm)  
Elec.  
 (type power)

(7) electric log NO  
 (yes or no)

(organization running log)

(8) how well bottom plugged Steel  
Plate

CODED

DEPT. OF NATURAL RESOURCES  
 BUREAU OF LAND & WATER RESOURCES


JUL 16 1981

RECEIVED

DRILLERS REMARKS:

If well telescopes please sketch and show depths.

GROUND LEVEL

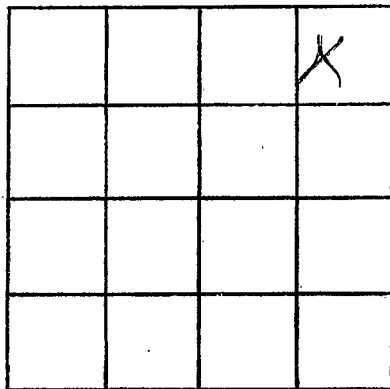

SECTION 34

Please indicate well location X.

ADDITIONAL INFORMATION

If more than one screen, show locations of each on sketch.