

SUNFLOWER
M 50
7-29-81

MISSISSIPPI DEPARTMENT OF NATURAL RESOURCES
 Bureau of Land and Water Resources
 Southport Mall
 P.O. Box 10631
 Jackson, Mississippi 39209
WATER WELL DRILLERS LOG

CODED

7-29- 1981 Dyn Well & Dring Sunflower
 date well completed firm name county well located

LANDOWNER:
Burke Fisher
Holly Ridge, MS.
 (mailing address)

WELL LOCATION:
 sec. 20 T 19 N R 5 E
3 miles NE of Holly Ridge
 (distance) (direction) (nearest town)

description of formations encountered	from	to
<u>Clay</u>	<u>0</u>	<u>18</u>
<u>Fine Sand</u>	<u>18</u>	<u>28</u>
<u>Sand</u>	<u>25</u>	<u>56</u>
<u>Sand + gravel</u>	<u>56</u>	<u>113</u>

WELL PURPOSE:
 (home, irrigation, municipal, industrial)


WELL COMPLETION DATA:

(1) diameter (inches) 16"
 (2) total depth (feet) 113'
 (3) static water level (feet) 21 below above top of ground.
 (4) casing Steel 73'
 (material) (depth)
16 If telescope see back.
 (size)
 (5) screen 40 73'
 (length) (depth to top)
16 Steel
 (size) (material)
 (6) pump 60HP 3000
 (HP) (yield gpm)
Diesel
 (type power)
 (7) electric log NO
 (yes or no)

(organization running log)
 (8) how well bottom plugged Plate


DRILLERS REMARKS:

CODED

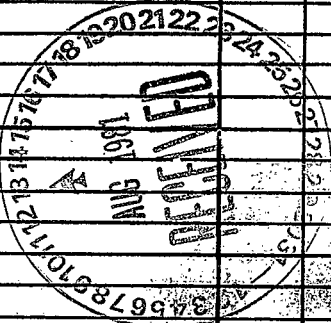

If well telescopes please sketch and show depths.

GROUND LEVEL

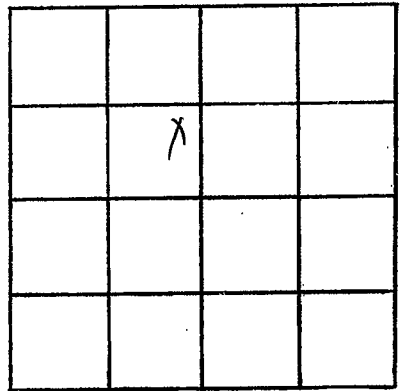

SECTION 20

Please indicate well location X.

ADDITIONAL INFORMATION

If more than one screen,
show locations of each on sketch.