

MISSISSIPPI DEPARTMENT OF NATURAL RESOURCES

Bureau of Land and Water Resources

Southport Mall

P.O. Box 10631

Jackson, Mississippi 39209

**CODED**

**WATER WELL DRILLERS LOG**

**SUNFLOWER**  
**M 52**  
**4/20/81**

date well completed April 20, 1981 firm name Larry's well & pump county well located Sunflower

LANDOWNER: <u>W.H. Baird</u>	description of formations encountered	from	to
<u>Indianola Ms.</u> (mailing address)	<u>CLAY</u> <u>FINE + MED SAND</u> <u>COARSE SAND</u>	<u>0</u> <u>40</u> <u>60</u>	<u>40</u> <u>60</u> <u>116</u>
<b>WELL LOCATION:</b> sec. <u>3</u> T. <u>19</u> N. R. <u>5</u> E <u>6</u> miles <u>NW</u> of <u>Indianola</u> (distance) (direction) (nearest town)			
<b>WELL PURPOSE:</b> (home, irrigation, municipal, industrial)			
<b>WELL COMPLETION DATA:</b>			
(1) diameter (inches) <u>16"</u>			
(2) total depth (feet) <u>116'</u>			
(3) static water level (feet) <u>22</u> below above top of ground.			
(4) casing <u>Steel</u> , <u>76'</u> (material) (depth) (size) if telescope see back.			
(5) screen <u>40'</u> , <u>76'</u> (length) (depth to top)			
<u>16"</u> , <u>Steel</u> (size) (material)			
(6) pump <u>600</u> , <u>3000</u> (HP) (yield gpm)			
(type power)			
(7) electric log <u>No.</u> (yes or no)			
(organization running log)			
(8) how well bottom plugged <u>Steel Plate</u>			
<b>DRILLERS REMARKS:</b>			

**CODED**


MISSISSIPPI DEPARTMENT OF NATURAL RESOURCES  
 BUREAU OF LAND & WATER RESOURCES

OCT 19 1981

**RECEIVED**

If well telescopes please sketch and show depths.

GROUND LEVEL

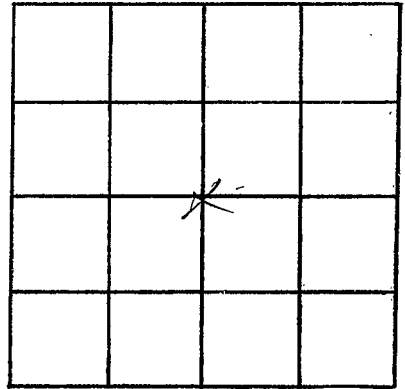

SECTION 3

Please indicate well location X.

ADDITIONAL INFORMATION

If more than one screen, show locations of each on sketch.