

MISSISSIPPI DEPARTMENT OF NATURAL RESOURCES

Bureau of Land and Water Resources

Southport Mall

P.O. Box 10631

Jackson, Mississippi 39209

WATER WELL DRILLERS LOG

CODED


Sunflower  
M 53  
4-15-81

April 15, 1981 date well completed  
Lamin's Well & Pump firm name  
Sunflower county well located

LANDOWNER: <u>W. H. Baird</u>	description of formations encountered	from	to
<u>Indianola, Mo.</u> (mailing address)	<u>CLAY</u>	<u>0</u>	<u>45</u>
WELL LOCATION: sec. <u>2 T19</u> N R. <u>5</u> <u>5</u> miles <u>NW</u> of <u>Indianola</u> (distance) (direction) (nearest town)	<u>FINE SAND</u>	<u>45</u>	<u>70</u>
WELL PURPOSE: (home, irrigation, municipal, industrial)	<u>MED + COARSE SAND</u>	<u>70</u>	<u>116</u>
WELL COMPLETION DATA: (1) diameter (inches) <u>10"</u>	CODED		
(2) total depth (feet) <u>116'</u>			
(3) static water level (feet) <u>22</u> below above top of ground.			
(4) casing <u>Steel</u> , <u>76'</u> (material) (depth)			
_____ if telescope see back. (size)			
(5) screen <u>40'</u> , <u>76'</u> (length) (depth to top)			
<u>10"</u> , <u>Steel</u> (size) (material)			
(6) pump <u>40</u> , <u>1500</u> (HP) (yield gpm)			
(type power)	DEPT. OF NATURAL RESOURCES BUREAU OF LAND & WATER RESOURCES		
(7) electric log <u>NO.</u> (yes or no)			
(organization running log)	RECEIVED		
(8) how well bottom plugged <u>Steel Plate</u>			
DRILLERS REMARKS:			

If well telescopes please sketch and show depths.

GROUND LEVEL

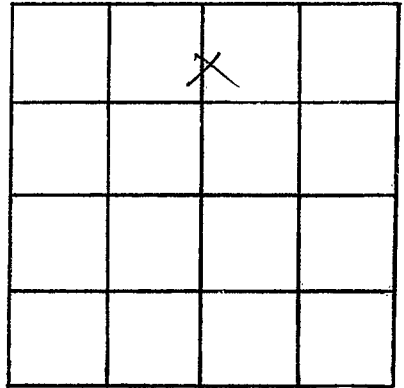

SECTION 2

Please indicate well location X.

ADDITIONAL INFORMATION

If more than one screen,  
show locations of each on sketch.