

MISSISSIPPI DEPARTMENT OF NATURAL RESOURCES

Bureau of Land and Water Resources

Southport Mall

P.O. Box 10631

Jackson, Mississippi 39209

WATER WELL DRILLERS LOG

CODED

SUNFLOWER
M 54
4-15-81

April 15, 1981 date well completed
Lamy's Well & Pump firm name
Sunflower county well located

LANDOWNER: <u>W.H. Baird</u>	description of formations encountered	from	to
<u>Juliana</u> (mailing address)	<u>CLAY</u>	<u>0</u>	<u>40</u>
WELL LOCATION: sec. <u>2</u> T. <u>19</u> N R. <u>5</u> E <u>5</u> miles <u>NW</u> of <u>Juliana</u> (distance) (direction) (nearest town)	<u>FINE SAND</u>	<u>40</u>	<u>65</u>
WELL PURPOSE: (home, irrigation, municipal, industrial)	<u>MED COARSE SAND</u>	<u>65</u>	<u>116</u>
WELL COMPLETION DATA:	CODED		
(1) diameter (inches) <u>16"</u>			
(2) total depth (feet) <u>116'</u>			
(3) static water level (feet) <u>22</u> below above top of ground.			
(4) casing <u>Steel</u> , <u>76'</u> (material) (depth) (size) If telescope see back.			
(5) screen <u>40'</u> , <u>76'</u> (length) (depth to top)			
(6) pump <u>16"</u> , <u>Steel</u> (size) (material)			
(6) pump <u>60</u> , <u>300</u> (HP) (yield gpm)			
(type power)	RECEIVED		
(7) electric log <u>NO</u> (yes or no)			
(organization running log)	OCT 19 1981		
(8) how well bottom plugged <u>Steel Plate</u>	RECEIVED		

DRILLERS REMARKS:


MISSISSIPPI DEPARTMENT OF NATURAL RESOURCES
BUREAU OF LAND & WATER RESOURCES

OCT 19 1981

RECEIVED

If well telescopes please sketch and show depths.

GROUND LEVEL

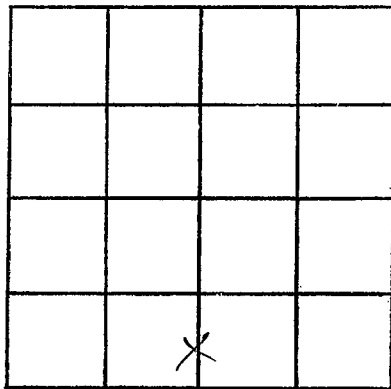

SECTION 2

Please indicate well location X.

ADDITIONAL INFORMATION

If more than one screen,
show locations of each on sketch.