

MISSISSIPPI DEPARTMENT OF NATURAL RESOURCES
 Bureau of Land and Water Resources
 Southport Mall
 P.O. Box 10631
 Jackson, Mississippi 39209
WATER WELL DRILLERS LOG

CODED

SUNFLOWER
M 55
10-30-81

10-30 1981 Dyer Well + Irrigation Sunflower
 date well completed firm name county well located

LANDOWNER: Seymour Johnson
P.O. Box 7
Indianola, Miss.
 (mailing address)

description of formations encountered	from	to
Clay	0	18
fine Sand	18	30
Sand	30	65
Sand + gravel	65	110

WELL LOCATION:
 sec. 15 T 19 N R. 5 E
4 miles NW of Indianola
 (distance) (direction) (nearest town)

WELL PURPOSE: Irrigation
 (home, irrigation, municipal, industrial)

WELL COMPLETION DATA:

- (1) diameter (inches) 16"
- (2) total depth (feet) 110
- (3) static water level (feet) 22 below above top of ground.
- (4) casing Steel, 70,
 (material) (depth)
16" If telescope see back.
 (size)
- (5) screen 40', 70
 (length) (depth to top)
16", Mild Steel
 (size) (material)
- (6) pump 40 2000
 (HP) (yield gpm)
Electric
 (type power)
- (7) electric log No
 (yes or no)
NONE
 (organization running log)
- (8) how well bottom plugged Plate

CODED

DEPT. OF NATURAL RESOURCES
 BUREAU OF LAND & WATER RESOURCES


NOV 6 1981

RECEIVED

DRILLERS REMARKS:

If well telescopes please sketch and show depths.

GROUND LEVEL

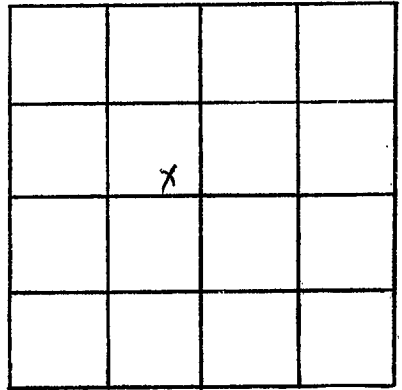

SECTION 15

Please indicate well location X.

ADDITIONAL INFORMATION

If more than one screen,
show locations of each on sketch.