

SUNFLOWER  
M 56  
11/24/81

MISSISSIPPI DEPARTMENT OF NATURAL RESOURCES  
Bureau of Land and Water Resources  
Southport Mall  
P.O. Box 10631  
Jackson, Mississippi 39209  
WATER WELL DRILLERS LOG

CODED

Nov. 24 1981 Pyer Well & Irrigation Sunflower  
date well completed firm name county well located

LANDOWNER: Holly Ridge Ph.  
Co. Indianola  
(mailing address)

description of formations encountered	from	to
Clay	0	30
fine sand	30	72
sand	72	55
sand & gravel	55	113

WELL LOCATION:  
sec. 20 T 19 S R 5 E  
2 miles N of Holly Ridge  
(distance) (direction) (nearest town)

WELL PURPOSE: Irrigation  
(home, irrigation, municipal, industrial)

- WELL COMPLETION DATA:
- (1) diameter (inches) 16"
  - (2) total depth (feet) 113'
  - (3) static water level (feet) 20' below top of ground.
  - (4) casing Steel, 73' (material), (depth)  
16" if telescope see back. (size)
  - (5) screen 40', 73' (length), (depth to top)  
16", Mild Steel (size), (material)
  - (6) pump 60 3000 (HP), (yield gpm)  
pump (type power)
  - (7) electric log No (yes or no)  
(organization running log)
  - (8) how well bottom plugged Plate

CODED

DEPT. OF NATURAL RESOURCES  
BUREAU OF LAND & WATER RESOURCES


DEC 10 1981

RECEIVED

DRILLERS REMARKS:

If well telescopes please sketch and show depths.

GROUND LEVEL

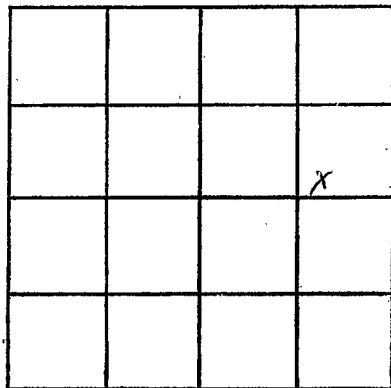

SECTION 20

Please indicate well location X.

ADDITIONAL INFORMATION

If more than one screen,  
show locations of each on sketch.