

SUNFLOWER  
M 57  
12/2/81

MISSISSIPPI DEPARTMENT OF NATURAL RESOURCES  
Bureau of Land and Water Resources  
Southport Mall  
P.O. Box 10631  
Jackson, Mississippi 39209  
WATER WELL DRILLERS LOG

**CODED**

Abt. Dec 2. 1981 Dyer Wells & Irrigation Sunflower  
date well completed firm name county well located


LANDOWNER: <u>Holly Ridge PhCo</u>	description of formations encountered	from	to
<u>Indianola, Ms</u> (mailing address)	<u>Clay</u>	<u>0</u>	<u>28</u>
<b>WELL LOCATION:</b> sec. <u>20</u> T <u>19</u> (N) S R <u>5</u> E (W)	<u>Fin sand</u>	<u>28</u>	<u>38</u>
<u>3</u> miles <u>N</u> of <u>Holly Ridge</u> (distance) (direction) (nearest town)	<u>Sand</u>	<u>38</u>	<u>55</u>
<b>WELL PURPOSE:</b> <u>Irrigation</u> (home, irrigation, municipal, industrial)	<u>Sand &amp; Gravel</u>	<u>55</u>	<u>110</u>
<b>WELL COMPLETION DATA:</b>			
(1) diameter (inches) <u>16"</u>			
(2) total depth (feet) <u>110'</u>			
(3) static water level (feet) <u>20'</u> below top of ground.			
(4) casing <u>Steel</u> , <u>70'</u> (material) (depth) <u>16"</u> if telescope see back. (size)	<b>CODED</b>		
(5) screen <u>40'</u> , <u>70'</u> (length) (depth to top)			
(6) pump <u>16"</u> , <u>Mild Steel</u> (size) (material)			
(6) pump <u>40</u> , <u>2000</u> (HP) (yield gpm)			
(7) electric log <u>Propose</u> (type power)			
(7) electric log <u>No</u> (yes or no)			
(8) (organization running log)			
(8) how well bottom plugged <u>Plate</u>			
DRILLERS REMARKS:			

DEPT. OF NATURAL RESOURCES  
BUREAU OF LAND & WATER RESOURCES

DEC 10 1981  
**RECEIVED**

If well telescopes please sketch and show depths.

GROUND LEVEL

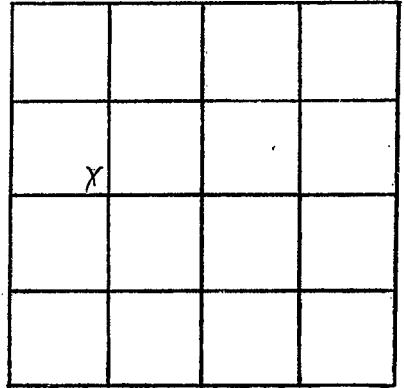

SECTION 20

Please indicate well location X.

ADDITIONAL INFORMATION

If more than one screen,  
show locations of each on sketch.