

MISSISSIPPI DEPARTMENT OF NATURAL RESOURCES

Bureau of Land and Water Resources

Southport Mall

P.O. Box 10631

Jackson, Mississippi 39209

WATER WELL DRILLERS LOG

CODED

SUNFLOWER
M 58
4/11/81

date well completed April 11 1981 Larry's Well & Pump Supply firm name Sunflower county well located

LANDOWNER: <u>Phillip Fratesi</u>	description of formations encountered	from	to
<u>Indian, Miss</u> (mailing address)	<u>CLAY</u>	<u>0'</u>	<u>19'</u>
	<u>SAND</u>	<u>19'</u>	<u>100'</u>
	<u>GRAVEL</u>	<u>100'</u>	<u>115'</u>
	<u>CLAY</u>	<u>115'</u>	<u>180'</u>
	<u>SAND</u>	<u>180'</u>	<u>320'</u>
	<u>CLAY</u>	<u>320'</u>	<u>360'</u>
	<u>SAND</u>	<u>360'</u>	<u>480'</u>
	<u>CLAY</u>	<u>480'</u>	<u>580'</u>
	<u>SAND</u>	<u>580'</u>	<u>640'</u>
	<u>CLAY</u>	<u>640'</u>	<u>700'</u>
	<u>SAND</u>	<u>700'</u>	<u>800'</u>
WELL LOCATION: sec. <u>25</u> T. <u>19</u> N. R. <u>5</u> E. W. <u>W</u>			
<u>1/2</u> miles <u>N</u> of <u>Indian</u> (distance) (direction) (nearest town)			
WELL PURPOSE: <u>Fish Hatchery</u> (home, irrigation, municipal, industrial)			
WELL COMPLETION DATA:			
(1) diameter (inches) <u>4" x 3"</u>			
(2) total depth (feet) <u>800'</u>			
(3) static water level (feet) <u>28'</u> below top of ground.			
(4) casing <u>STEEL</u> , <u>120'</u> of <u>4"</u> (material) (depth) <u>650'</u> of <u>3"</u> (size) if telescope see back.			
(5) screen <u>30'</u> , <u>770'</u> (length) (depth to top) <u>3"</u> , <u>STEEL</u> (size) (material)			
(6) pump <u>3</u> , <u>60</u> (HP) (yield gpm) <u>Electric</u> (type power)			
(7) electric log <u>NO</u> (yes or no) (organization running log)			
(8) how well bottom plugged <u>SANDSHARK</u>			
DRILLERS REMARKS:			

CODED


DEPT. OF NATURAL RESOURCES
BUREAU OF LAND & WATER RESOURCES

JAN 8 1982

RECEIVED

If well telescopes please sketch and show depths.

GROUND LEVEL

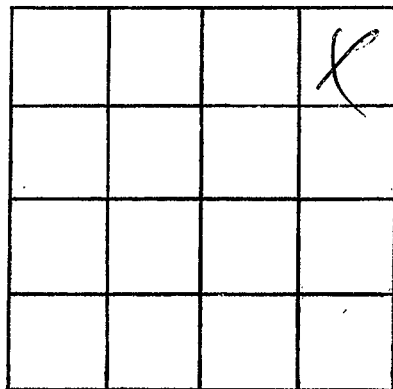

SECTION 25

Please indicate well location X.

ADDITIONAL INFORMATION

If more than one screen, show locations of each on sketch.