

Sunflower
M 61
3/3/82

MISSISSIPPI DEPARTMENT OF NATURAL RESOURCES
 Bureau of Land and Water Resources
 Southport Mall
 P.O. Box 10631
 Jackson, Mississippi 39209
WATER WELL DRILLERS LOG

CODED

33 1982 Dyer Well Sunflower
 date well completed firm name county well located
Bellevue

LANDOWNER: Seymour Johnson
 (mailing address)

WELL LOCATION:
 sec. 10 T 19 (N) R 5 (E)
3 miles NW of Indianola
 (distance) (direction) (nearest town)

WELL PURPOSE:
 (home, irrigation, municipal, industrial)

WELL COMPLETION DATA:

(1) diameter (inches) 16"

(2) total depth (feet) 113

(3) static water level (feet) 12 below above top of ground.

(4) casing Steel 73
 (material) (depth)
16" If telescope see back.
 (size)

(5) screen 40' 16" Mild Steel
 (length) (depth to top) (size) (material)

(6) pump 40 2000
 (HP) (yield gpm)
electric
 (type power)

(7) electric log No
 (yes or no)

(organization running log)

(8) how well bottom plugged Plate

DRILLERS REMARKS:

description of formations encountered	from	to
Clay	0	13
Clay	13	23
Clay	23	33
Sand	33	43
Sand	43	53
Sand	53	63
C Sand	63	73
C Sand	73	83
C Sand	83	93
Sand & Gravel	93	103
Sand & Gravel	103	113


DEPT. OF NATURAL RESOURCES
 BUREAU OF LAND & WATER RESOURCES

JUN 30 1982

RECEIVED

If well telescopes please sketch and show depths.

GROUND LEVEL

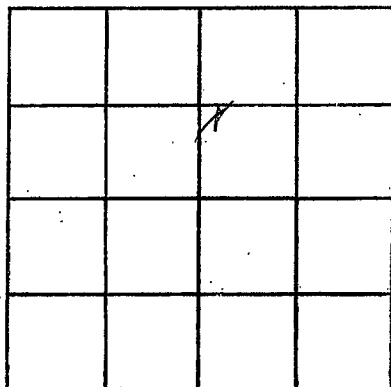

SECTION 10

Please indicate well location X.

ADDITIONAL INFORMATION

If more than one screen,
show locations of each on sketch.