

MISSISSIPPI DEPARTMENT OF NATURAL RESOURCES

Bureau of Land and Water Resources

Southport Mall

P.O. Box 10631

Jackson, Mississippi 39209

WATER WELL DRILLERS LOG

CODED

Sunflower  
M 63  
5/18/82

5-18-82 date well completed      Dyer Well firm name      Sunflower county well located

LANDOWNER: B. J. Dyer  
 (mailing address)  
 WELL LOCATION:  
 sec. 16 T. 19 N. R. 5 E.  
4 miles SW of Holly Ridge  
 (distance) (direction) (nearest town)

description of formations encountered	from	to
<u>Clay</u>	<u>0</u>	<u>28</u>
<u>lime sand</u>	<u>28</u>	<u>40</u>
<u>sand</u>	<u>40</u>	<u>54 1/2</u>
<u>sand &amp; gravel</u>	<u>54</u>	<u>93</u>

WELL PURPOSE:  
 (home, irrigation, municipal, industrial)

WELL COMPLETION DATA:

(1) diameter (inches) 16

(2) total depth (feet) 93

(3) static water level (feet) 13 below above top of ground.

(4) casing steel 53  
 (material) (depth)

16 if telescope see back.  
 (size)

(5) screen 40 53  
 (length) (depth to top)

16 steel-mild  
 (size) (material)

(6) pump 60 3000  
 (HP) (yield gpm)

diesel  
 (type power)

(7) electric log no  
 (yes or no)

(organization running log)

(8) how well bottom plugged no plate


DRILLERS REMARKS:

DEPT. OF NATURAL RESOURCES  
 BUREAU OF LAND & WATER RESOURCES

SEP 30 1982  
 RECEIVED

If well telescopes please sketch and show depths.

GROUND LEVEL

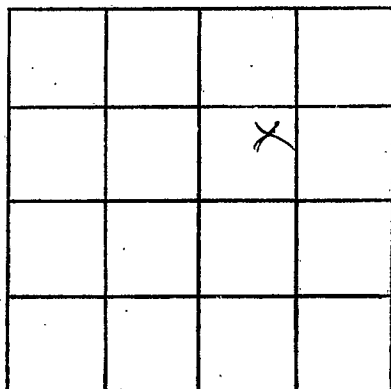

SECTION 16

Please indicate well location X.

ADDITIONAL INFORMATION

If more than one screen, show locations of each on sketch.