

MISSISSIPPI DEPARTMENT OF NATURAL RESOURCES

Bureau of Land and Water Resources

Southport Mall

P.O. Box 10631

Jackson, Mississippi 39209

WATER WELL DRILLERS LOG

CODED

Sunflower
M 65
5/30/82

date well completed 19 June well firm name Well county well located Sunflower

LANDOWNER: Holly Ridge
Jon Robinson

description of formations encountered	from	to
Clay	0	28
Fine Sand	28	37
Sand + gravel	37	70
Fine Sand	70	86
Sand + gravel	86	123

(mailing address)

WELL LOCATION:

sec 29 T 19 (N) R 5 (E)
5 miles (distance) W (direction) of Indian (nearest town)

WELL PURPOSE:

(home, irrigation, municipal, industrial)

WELL COMPLETION DATA:

- (1) diameter (inches) 16"
- (2) total depth (feet) 123
- (3) static water level (feet) 24 below above top of ground.
- (4) casing Steel (material), 83 (depth), 16 (size) if telescope see back.
- (5) screen 40 (length), 123 (depth to top), 16 (size), Mild Steel (material)
- (6) pump 40 (HP), 2000 (yield gpm), Diesel (type power)
- (7) electric log NO (yes or no)

(organization running log)

(8) how well bottom plugged plate

DRILLERS REMARKS:


DEPT. OF NATURAL RESOURCES
 BUREAU OF LAND & WATER RESOURCES

SEP 30 1982

RECEIVED

If well telescopes please sketch and show depths.

GROUND LEVEL

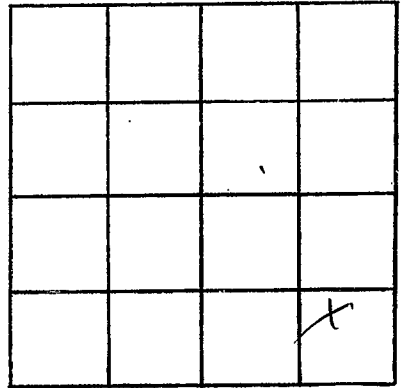

SECTION 29

Please indicate well location X.

ADDITIONAL INFORMATION

If more than one screen, show locations of each on sketch.