

MISSISSIPPI DEPARTMENT OF NATURAL RESOURCES

Bureau of Land and Water Resources

Southport Mall

P.O. Box 10631

Jackson, Mississippi 39206

CODED

WATER WELL DRILLERS LOG

Sunflower  
M 68  
5/16/82

Deep Well Drilling Sunflower  
 firm name county well located

19 \_\_\_\_\_ date well completed

LANDOWNER: Holly Ridge

description of formations encountered

from

to

(mailing address)

WELL LOCATION:

sec. 20 T 19 N R 5 E  
4 miles EN of Holly Ridge  
 (distance) (direction) (nearest town)

Clay 0 26  
Fine Sand 26 77  
~~Sand + gravel 34 77~~  
Sand + gravel 74 89  
Fine Sand 89 99  
Sand + gravel 99 113

WELL PURPOSE:

(home, irrigation, municipal, industrial)

WELL COMPLETION DATA:

- (1) diameter (inches) 16
- (2) total depth (feet) 113
- (3) static water level (feet) 20 below above top of ground.
- (4) casing Steel 73  
 (material) (depth)
- \_\_\_\_\_ If telescope see back.  
 (size)
- (5) screen 40' 40'  
 (length) (depth to top)
- 16" steel  
 (size) (material)
- (6) pump 30 1500  
 (HP) (yield gpm)
- diesel  
 (type power)
- (7) electric log no  
 (yes or no)
- no  
 (organization running log)
- (8) how well bottom plugged plate

DEPT. OF NATURAL RESOURCES  
 BUREAU OF LAND & WATER RESOURCES


FEB - 3 1983

RECEIVED

DRILLERS REMARKS:

If well telescopes please sketch and show depths.

GROUND LEVEL

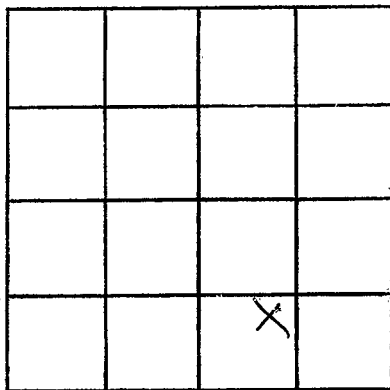

SECTION 20

Please indicate well location X.

ADDITIONAL INFORMATION

If more than one screen,  
show locations of each on sketch.