

MISSISSIPPI DEPARTMENT OF NATURAL RESOURCES
Bureau of Land and Water Resources
 Southport Mall
 P.O. Box 10631
 Jackson, Mississippi 39209
WATER WELL DRILLERS LOG

CODED

M 67
 Sunflower
 11-12-83

11-12 1983 Butang Dao of Sunflower
 date well completed firm name county well located

Greenwood

LANDOWNER:
Vic Zepper
 (mailing address)

description of formations encountered	from	to
	<u>CLAY</u>	<u>0</u>
<u>SAND</u>	<u>20</u>	<u>40</u>
<u>sand & gravel</u>	<u>20</u>	<u>103</u>

WELL LOCATION:
 sec. 31 T. 19N R. 5E
 S W
6.5 miles W of Indian
 (distance) (direction) (nearest town)

CODED

WELL PURPOSE: irrigation
 (home, irrigation, municipal, industrial)


- WELL COMPLETION DATA:**
- (1) diameter (inches) 12"
 - (2) total depth (feet) 103
 - (3) static water level (feet) 30 below above top of ground.
 - (4) casing Steel, 63,
 (material) (depth)
12" if telescope see back.
 (size)
 - (5) screen 40, 63
 (length) (depth to top)
12", Steel
 (size) (material)
 - (6) pump 60, 600
 (HP) (yield gpm)
Diesel
 (type power)
 - (7) electric log No
 (yes or no)
No
 (organization running log)
 - (8) how well bottom plugged Steel plug

DRILLERS REMARKS:
Carlos Ramos

DEPT. OF NATURAL RESOURCES
 BUREAU OF LAND & WATER RESOURCES
 DEC 15 1983
RECEIVED

If well telescopes please sketch and show depths.

GROUND LEVEL

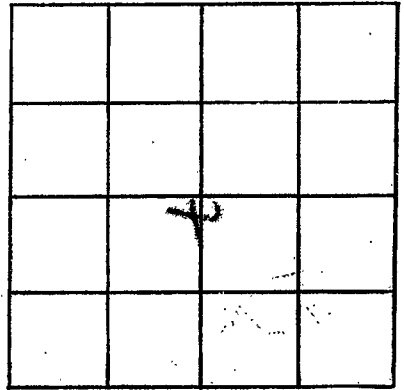

SECTION 31

Please indicate well location X.

ADDITIONAL INFORMATION

If more than one screen, show locations of each on sketch.