

MISSISSIPPI DEPARTMENT OF NATURAL RESOURCES
Bureau of Land and Water Resources
Southport Mall
P.O. Box 10631
Jackson, Mississippi 39209
WATER WELL DRILLERS LOG

M 68
Sunflower Co
3-15-84

CODED

March 15, 1984 Irrigation Equipment, Inc. Sunflower
 date well completed firm name county well located

LANDOWNER: Seymour Johnson	description of formations encountered	from	to
101 S. Sunflower Ave. Indianola, Ms. 38751 (mailing address)			
	Coarse Sand & Gravel	20	95
	Clay	95	105

WELL LOCATION:
 sec. 3 T 19 S R 8 E
5.5 miles NNE of Holly Ridge
 (distance) (direction) (nearest town)

CODED

WELL PURPOSE: Irrigation
 (home, irrigation, municipal, industrial)

WELL COMPLETION DATA:

- (1) diameter (inches) 16"
- (2) total depth (feet) 95'
- (3) static water level (feet) 21 (below/above top of ground)
- (4) casing Steel, 55'
 (material) (depth)
 (size) if telescope see back.
- (5) screen 40', 55'
 (length) (depth to top)
16", Steel
 (size) (material)
- (6) pump 80 1300
 (HP) (yield gpm)
Deisel
 (type power)
- (7) electric log (yes or no)

(organization running log)

(8) how well bottom plugged Steel plate

DEPT. OF NATURAL RESOURCES
 BUREAU OF LAND & WATER RESOURCES


MAR 26 1984

DRILLERS REMARKS:

RECEIVED

If well telescopes please sketch and show depths.

GROUND LEVEL

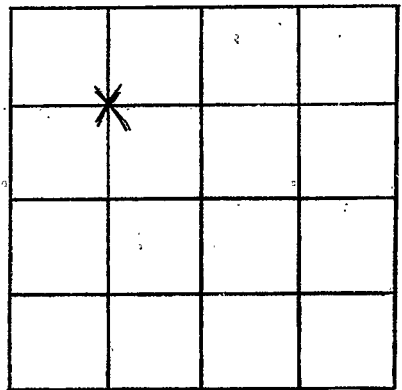

SECTION _____

Please indicate well location X.

ADDITIONAL INFORMATION

If more than one screen,
show locations of each on sketch.