

MISSISSIPPI DEPARTMENT OF NATURAL RESOURCES
 Bureau of Land and Water Resources
 Southport Mall
 P.O. Box 10631
 Jackson, Mississippi 39209
WATER WELL DRILLERS LOG

M69
Sunflower Co.
3-19-84

CODED

March 19, 1984 Irrigation Equip., Inc. Sunflower
 date well completed firm name county well located

LANDOWNER:	description of formations encountered	from	to
Seymour Johnson	Clay	0	15
101 S. Sunflower Ave.	Fine Sand	15	25
Indianola, Ms. 38751	Coarse Sand & Gravel	25	100
(mailing address)	Clay	100	110
WELL LOCATION:			
sec. <u>3</u> T. <u>19</u> S. R. <u>5</u> E			
<u>3.5</u> miles <u>NNE</u> of <u>Holly Ridge</u>			
(distance) (direction) (nearest town)			
WELL PURPOSE: Irrigation			
(home, irrigation, municipal, industrial)			
WELL COMPLETION DATA:			
(1) diameter (inches) <u>16"</u>			
(2) total depth (feet) <u>100'</u>			
(3) static water level (feet) <u>20</u> <u>below</u> above top of ground.			
(4) casing <u>Steel</u> , <u>60'</u> (material), (depth), (size) if telescope see back.			
(5) screen <u>40'</u> , <u>60'</u> (length), (depth to top) <u>12"</u> , <u>Steel</u> (size), (material)			
(6) pump <u>80</u> , <u>1300</u> (HP), (yield gpm) <u>Diesel</u> (type power)			
(7) electric log (yes or no) _____			
(organization running log) _____			
(8) how well bottom plugged <u>Steel plate</u>			
DRILLERS REMARKS:			

CODED


DEPT. OF NATURAL RESOURCES
 BUREAU OF LAND & WATER RESOURCES

MAR 26 1984

RECEIVED

If well telescopes please sketch and show depths.

GROUND LEVEL

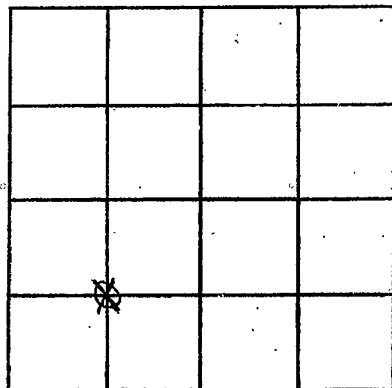

SECTION _____

Please indicate well location X.

ADDITIONAL INFORMATION

If more than one screen, show locations of each on sketch.