

MISSISSIPPI DEPARTMENT OF NATURAL RESOURCES

Bureau of Land and Water Resources

Southport Mall

P.O. Box 10631

Jackson, Mississippi 39209

WATER WELL DRILLERS LOG

M 70  
Sunflower Co  
3-21-84

CODED

March 21, 1984 Irrigation Equip., Inc. Sunflower  
date well completed firm name county well located

LANDOWNER: Seymour Johnson	description of formations encountered		from	to
101 S. Sunflower Ave.	Clay		0	15
Indianola, Ms. 38751 (mailing address)	Fine Sand		15	75
	Coarse Sand & Gravel		75	115

WELL LOCATION:  
sec. 6 T 17 N R 5 E  
S W  
2 1/2 miles ENE of Woodburn  
(distance) (direction) (nearest town)

WELL PURPOSE: Irrigation  
(home, irrigation, municipal, industrial)

- WELL COMPLETION DATA:
- (1) diameter (inches) 16"
  - (2) total depth (feet) 115'
  - (3) static water level (feet) 20 below top of ground.
  - (4) casing Steel, 75'  
(material) (depth)  
If telescope see back.  
(size)
  - (5) screen 40', 75'  
(length) (depth to top)  
16", Steel  
(size) (material)
  - (6) pump 200 2500  
(HP) (yield gpm)  
Deisel  
(type power)
  - (7) electric log (yes or no)  
(organization running log)
  - (8) how well bottom plugged Steel Plate

CODED

DEPT. OF NATURAL RESOURCES  
BUREAU OF LAND & WATER RESOURCES


MAR 26 1984

RECEIVED

DRILLERS REMARKS:

If well telescopes please sketch and show depths.

GROUND LEVEL

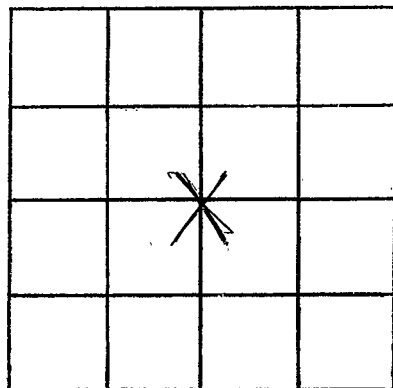

SECTION \_\_\_\_\_

Please indicate well location X.

ADDITIONAL INFORMATION

If more than one screen,  
show locations of each on sketch.