

MISSISSIPPI DEPARTMENT OF NATURAL RESOURCES

Bureau of Land and Water Resources

Southport Mall

P.O. Box 10631

Jackson, Mississippi 39209

WATER WELL DRILLERS LOG

CODED

SUNFLOWER

M 71

March 15 1984 Larry's Well & Pump Sunflower  
 date well completed firm name county well located

LANDOWNER: Charlie Palasini

Indianola Miss

description of formations encountered

from

to

(mailing address)

slay	0	30
Fine Sand	30	70
Coarse Sand	70	120

WELL LOCATION:

sec. 32 T. 19 N R. E  
 S S W  
 1 miles N of Holly Ridge  
 (distance) (direction) (nearest town)

CODED

WELL PURPOSE:

(home, irrigation, municipal, industrial)

WELL COMPLETION DATA:

- (1) diameter (inches) 12"
- (2) total depth (feet) 120'
- (3) static water level (feet) 24' below above top of ground.
- (4) casing Steel, 80'  
 (material) (depth)  
 (size) If telescope see back.
- (5) screen 46', 80'  
 (length) (depth to top)  
12", Steel  
 (size) (material)
- (6) pump 30, 600  
 (HP) (yield gpm)  
0  
 (type power)
- (7) electric log NO  
 (yes or no)

(organization running log)


- (8) how well bottom plugged Steel Plate

DRILLERS REMARKS:

MISSISSIPPI DEPARTMENT OF NATURAL RESOURCES  
 BUREAU OF LAND & WATER RESOURCES  
 AUG 28 1984  
 RECEIVED

If well telescopes please  
sketch and show depths.

GROUND LEVEL

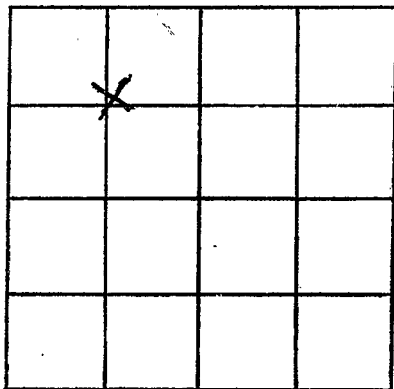

SECTION 32

Please indicate well location X.

ADDITIONAL INFORMATION

If more than one screen,  
show locations of each on sketch.