

MISSISSIPPI DEPARTMENT OF NATURAL RESOURCES

Bureau of Land and Water Resources

Southport Mall

P.O. Box 10631

Jackson, Mississippi 39209

WATER WELL DRILLERS LOG

CODED

SUNFLOWER
M 75

10-3-84

IRRIGATION Equipment Inc.

SUNFLOWER

date well completed

firm name

county well located

LANDOWNER: PAUL FRATESI

description of formations encountered

from

to

Marie Rd.

INDIANOLA, MS 38751

(mailing address)

Clay	0	40
fine sand	40	60
Coarse sand	60	100
sand and gravel	100	115

WELL LOCATION:

sec. 30 T 19 N R 5 E
2 miles west of INDIANOLA
(distance) (direction) (nearest town)

WELL PURPOSE: IRRIGATION
(home, irrigation, municipal, industrial)

CODED

WELL COMPLETION DATA:

- (1) diameter (inches) 10"
- (2) total depth (feet) 115'
- (3) static water level (feet) 16' below top of ground.
- (4) casing Steel 75'
(material) (depth)
(size) if telescope see back.
- (5) screen 40' 75'
(length) (depth to top)
10" Steel
(size) (material)
- (6) pump 25 700
(HP) (yield gpm)
Electric
(type power)
- (7) electric log (yes or no)

(organization running log)

(8) how well bottom plugged - steel plate


DRILLERS REMARKS:

DEPT. OF NATURAL RESOURCES
BUREAU OF LAND & WATER RESOURCES

OCT 11 1984
RECEIVED

If well telescopes please
sketch and show depths.

GROUND LEVEL

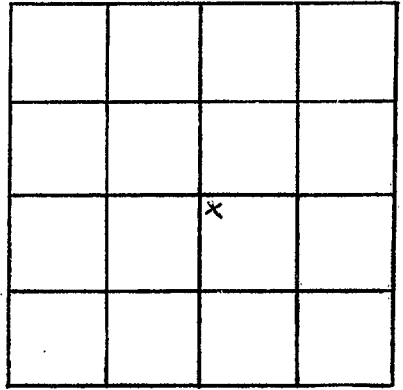

SECTION 30

Please indicate well location X.

ADDITIONAL INFORMATION

If more than one screen,
show locations of each on sketch.