

MISSISSIPPI DEPARTMENT OF NATURAL RESOURCES

Bureau of Land and Water Resources

Southport Mall

P.O. Box 10631

Jackson, Mississippi 39209

WATER WELL DRILLERS LOG

CODED

SUNFLOWER

M 77

4-9-85

date well completed

IRRIGATION Equipment

firm name

Sunflower

county well located

LANDOWNER: Billups Plantation

description of formations encountered

from

to

Rt. 1 Indianola, MS 38751

fine sand

0

40

J.W. Waldrop

clay

40

55

(mailing address)

course sand

55

110

WELL LOCATION:

COURSE SAND / PEAGRAVEL

110

120

sec. 33 T. 19 N. R. 5 E.

4 miles West of Indianola

(distance) (direction) (nearest town)

WELL PURPOSE: Irrigation  
(home, irrigation, municipal, industrial)

WELL COMPLETION DATA:

- (1) diameter (inches) 16"
- (2) total depth (feet) 120
- (3) static water level (feet) 19 below above top of ground.
- (4) casing STEEL 80' (material) (depth)

(size) if telescope see back.

- (5) screen 40' 80' (length) (depth to top)
- 16" steel (size) (material)

- (6) pump 40 2000 (HP) (yield gpm)

DIESEL (type power)

- (7) electric log NO (yes or no)

(organization running log)

- (8) how well bottom plugged steel plate

DRILLERS REMARKS:


CODED

RECEIVED  
APR 23 1985

Department of Natural Resources  
Bureau of Land & Water Resources

If well telescopes please sketch and show depths.

GROUND LEVEL

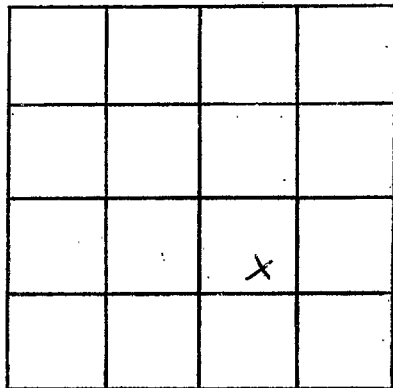

SECTION 33

Please indicate well location X.

ADDITIONAL INFORMATION

If more than one screen,  
show locations of each on sketch.