

MISSISSIPPI DEPARTMENT OF NATURAL RESOURCES

Bureau of Land and Water Resources

Southport Mall

P.O. Box 10631

Jackson, Mississippi 39209

WATER WELL DRILLERS LOG

TEP CODED
88188-CMG-01
M 96

7-6
date well completed

88 Dyer Well
firm name

Sunflower
county well located

LANDOWNER

John W. McPherson

description of formations encountered

from to

Box 690
Indianola Ms 38751
(mailing address)

Clay	0	28
Fine Sand	28	65
M Sand + Gravel	65	75
Sand + Gravel	75	80
Fine Sand	80	95
Fine Sand + Gravel	95	101
Fine Sand	101	118
Sand + Gravel	118	138
M Sand + Gravel	138	150

WELL LOCATION:

sec. 11 T 19 N R. 5 E
5 miles NW Indianola
(distance) (direction) (nearest town)

WELL PURPOSE: Irrigation
(home, irrigation, municipal, industrial)

WELL COMPLETION DATA:

- (1) diameter (inches) 16"
- (2) total depth (feet) 150'
- (3) static water level (feet) _____ below above top of ground.
- (4) casing steel (material), _____ (depth),
16" (size) if telescope see back.
- (5) screen 40' (length), _____ (depth to top),
16" (size), _____ (material)
- (6) pump 60 (HP), _____ (yield gpm)
Gear (type power)
- (7) electric log No (yes or no)
None (organization running log)
- (8) how well bottom plugged Plate

RECEIVED


JUL 11 1999

DRILLERS REMARKS:

Department of Natural Resources
Bureau of Land & Water Resources

If well telescopes please sketch and show depths.

GROUND LEVEL

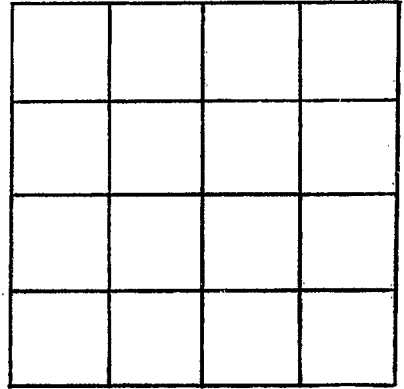

SECTION _____

Please indicate well location X.

ADDITIONAL INFORMATION

If more than one screen, show locations of each on sketch.