

MISSISSIPPI DEPARTMENT OF NATURAL RESOURCES

Bureau of Land and Water Resources

COUNTY WELL LOCATED Sunflower	
WELL NUMBER M 99	CODED
DATE WELL COMPLETED 6-25-89	

147A

PERMIT NUMBER
NAME OF DRILLING FIRM IRRIGATION EQUIPMENT
PHONE NUMBER 601/887-2555
LOCATION INDIANOLA, MS

CODED

P.O. Box 10631

Jackson, Mississippi 39209

WATER WELL DRILLERS LOG

NAME & MAILING ADDRESS OF LANDOWNER American Legion Post #2		
P.O. Box 1016		
INDIANOLA, MS		
WELL LOCATION: SEC	TOWNSHIP	RANGE
23	19	5
	N S	E W
DISTANCE	DIRECTION	NEAREST TOWN
3 Miles	NW	INDIANOLA
OTHER LANDMARK		
WELL PURPOSE: Home, Irrigation, Municipal, Industrial, Fish Pond, etc. IRRIGATION-PIVOT		

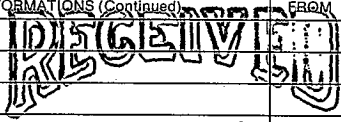
PUMP DATA		
PUMP TYPE (Circle One): Submersible, <u>Turbine</u> , Jet, Flowing Well, Other (Describe) _____		
POWER TYPE (Circle One): Electric, Tractor, <u>Diesel</u> , Gasoline, Butane, Other (Describe) _____ H/P 40		
Pump Capacity (GPM)	No. of Stages	Setting Depth
800	4	50 FT.
PUMP TEST		
Well yielded _____ GPM with a drawdown of _____ ft. after _____ hours of pumping		

WELL DATA		
Well Depth	Casing Diameter (In.)	Casing Length (Ft.)
110	10	70
Type of Casing	Hole Depth	Depth to Static Water Level
PVC	110	24'
TYPE OF COMPLETION: (Circle One or More): <u>Gravel Packed</u> , Underreamed, Telescoped, Natural Development, Open Hole, Other (Describe) _____		
Top of Lap Pipe or Reduction in Casing		
FEET	IF TELESCOPED OR MORE THAN ONE SCREEN: USE BACK PAGE	

LOG DATA	
TYPE OF LOG RUN (Circle One): No Log Run, Electric, Gamma Ray, Density, Sonic, Neutron, Other (Describe) _____	
Name of Organization Running Log	

SCREEN DATA		
Diameter - Inches	Length - Feet	Slot Size - Inches
10	40	.050
Screen Type	Depth to Bottom - Feet	
PVC	110	

GEOLOGIC DATA (Office Use Only)			
Surface Elev.	Geologic Unit	Unit Thickness	Depth to Top
Subs. SWL	Date	Analysis	Aquifer Test
Driller's Remarks GARY Rochelle			

DESCRIPTION OF FORMATIONS ENCOUNTERED	FROM	TO	FORMATIONS (Continued)	FROM	TO
Clay	0	20	 FEB 12 1990 Department of Natural Resources Bureau of Land & Water Resources		
FINE SAND	20	45			
MEDIUM SAND	45	70			
COARSE SAND	70	85			
COARSE SAND & GRAVEL	85	95			
COARSE SAND	95	105			
MEDIUM SAND	105	110			

IF MORE SPACE IS NEEDED, USE BACK

IRRIGATION EQUIPMENT
601/887-2555
INDIANOLA, MS

If well telescopes please
sketch and show depths.

GROUND LEVEL

	X		

SECTION 23

Please indicate well location X.

ADDITIONAL INFORMATION

If more than one screen,
show location of each on sketch.