

MISSISSIPPI DEPARTMENT OF ENVIRONMENTAL QUALITY

Office of Land and Water Resources

P. O. Box 10631

Jackson, MS 39289-0631

WATER WELL DRILLERS LOG

COUNTY WELL LOCATED <i>Sunflower</i>	
WELL NUMBER M-162	CODED
DATE WELL COMPLETED 12-3-03	

PERMIT NUMBER
NAME OF DRILLING FIRM KATI, L.F. WATER WELL SERV.
Holcomb Ms. 38940

NAME & MAILING ADDRESS OF LANDOWNER BEAVER DAM FRESH FARMS			
135 BEAVER DAM RD. INDIANOLA MS.			
Latitude: Longitude:			
WELL LOCATION:	SEC 28	TOWNSHIP 19 N	RANGE 5 E
DISTANCE 2 Miles	DIRECTION N.W.	NEAREST TOWN INDIANOLA	
OTHER LANDMARK			
WELL PURPOSE: Home <input checked="" type="radio"/> Irrigation <input type="radio"/> Municipal, Industrial, Fish Pond, etc.			

PUMP DATA

PUMP TYPE (Circle One):
 Submersible Turbine Jet Flowing Well,
 Other (Describe) _____

POWER TYPE (Circle One):
 Electric Tractor, Diesel, Gasoline, Butane,
 Other (Describe) _____ H/P **1hp**

DESCRIPTION OF FORMATIONS ENCOUNTERED	FROM	TO
CLAY	0	30
CLAY & SAND	30	45
SAND	45	75

RECEIVED
 DEC 19 2003
 BY: OLWR

Well Depth 65'	Casing Diameter (In.) 4"	Casing Length (Ft.) 55'
Type of Casing PVC	Hole Depth 76'	Depth to Static Water Level 26'
TYPE OF COMPLETION: (Circle One or More): <input checked="" type="radio"/> Gravel-Packed <input type="radio"/> Underreamed, Telescoped, <input checked="" type="radio"/> Natural Development <input type="radio"/> Open Hole, Other (Describe) _____		
WELL GROUTED TO A DEPTH OF 10 FEET Type Grout (circle one): Cement, Bentonite, or Mix		

SCREEN DATA		
Diameter - Inches 4"	Length - Feet 10	Slot Size - Inches 8
Screen Type PVC	Depth to Bottom - Feet 65'	

Top of Lap Pipe or Reduction in Casing
FEET IF TELESCOPED OR MORE THAN ONE SCREEN: USE BACK PAGE

I certify that the well was drilled, constructed and completed in accordance with all applicable Requirements of the Mississippi Department of Environmental Quality and/or the Mississippi Department of Health regulations and state laws.


[Signature]
 Signature of Licensed Driller and License No. **0-002**

12-04-03
 Date

Additional Information Required On Back

If well telescopes please sketch and show depths.

GROUND LEVEL

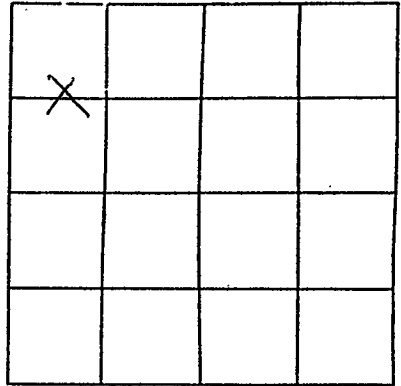

SECTION 28

Please indicate well location X.

Pump Capacity (GPM)	No. of Stages	Setting Depth	
<u>20</u>	<u>12</u>	<u>60'</u>	FT.

PUMP TEST

Well yielded 25 GPM with
a drawdown of 4 ft.
after 30 min. hours of pumping

LOG DATA

TYPE OF LOG RUN (Circle One): No Log Run.
Electric, Gamma Ray, Density, Sonic, Neutron,
Other (Describe) _____

Name of Organization Running Log

GEOLOGIC DATA (Office Use Only)

Surface Elev.	Geologic Unit	Unit Thickness	Depth to Top
Subs. SWL	Date	Analysis	Aquifer Test

Driller's Remarks

If more than one screen,
show location of each on sketch.