County:	Sunflow	er
	6w4	1728 Guipment
Driller: _		
Date drilli	ing completed: _	4-2-07

State Well Report

Part 1

Mississippi Department of Environmental Quality
Office of Land and Water Resources
P.O. Box 10631
Jackson, MS 39289-0631
(601)961-5210
(601)354-6938 (fax)

For Office Use Only:
Aquifer:
L. S. Elevation:
E-log #:

State Law requires that this report be prepared by the driller in detail and filed with the Department within

30 days of completion of drilling of the well.				
Well Owner Information	Well Location			
Owner Name McClain Farms	33 30 33.6 90 44 51.9W Latitude: " " Longitude: " " "			
Mailing Address: 164 Hays Road	Method of Lat/Long (circle one): Conventional Survey,			
	USGS quad, Hand-held GPS, Survey-grade GPS			
	NE 1/4 SE 1/4 Sec 7 Twn 19N Rng 5W			
Indianola MS 38751	1 Wil Wil Riger			
City State Zip Code	Distance Direction Nearest Town			
Telephone No. ()	6 Miles NW of Indianola			
Well I	Date:			
Purpose of Well (circle one) Home Industrial Public Supply	(trigation) Fish Culture Other:			
Date well drilling started: 4-2-07 Date v	well drilling completed: $4-2-0.7$			
If flowing, method of flow regulation: Valve Other (d	escribe)			
Static Water Level: 36 feet above or below (circle one) !	and surface Date measured: $4-4-0.7$			
Method of Measurement (circle one) teel tage electric tape air line other:				
Hole depth: 123 Well depth: 123 Well grouted to a depth of 10 feet				
Type of grout (circle one): Cement Bentonite Mix				
Casing length: 83 feet Casing diameter: 10 inches Type of casing: PVC160				
Screen length: 40 feet Screen diameter: 10	inches Type of screen: PVC160			
Screen slot size:050inches	8.4 feet to 123 feet			
Type of completion (circle all applicable): Gravel packed Underreamed Telescoped Open hole Natural Development				
Other (describe):				
Top of lap pipe or reduction in casing: feet. If tel	lescoped or more than one screen, describe on back of page			
Logs run (circle all applicable): No log run Electric Gamma Ray	Density Sonic Neutron Other:			
Name of organization running log(s):				
I certify that the well was drilled, constructed, and completed in a	accordance with all applicable requirements of the Mississippi			
Department of Environmental Quality and/or the Mississippi Department of Health regulations and state/laws.				
Irrigation Equipment Inc.	1.14/ 20 1			
Patrick M. Chism 0695	Tahn M Chi			
Print Name of Water Well Contractor and License No.	Signature of Water Well Contractor			

RECEIVED

APR 2 4 2007


BYOLWE

If well telescopes please sketch below and show depths.

Ground Level

Description of Formations Encountered	From	То
Clay Fine Sand/gravel Med. sand/gravel	0	41
Fine Sand/gravel	42	50
Med. sand/gravel	51_	123
	- 	+-+
	+	+
		1
	<u> </u>	
	<u> </u>	
		
		1
		┼┤
	┪	11
	1	+-+
	 	
		لــــــــــــــــــــــــــــــــــــــ

If more than one screen, show location of each on sketch

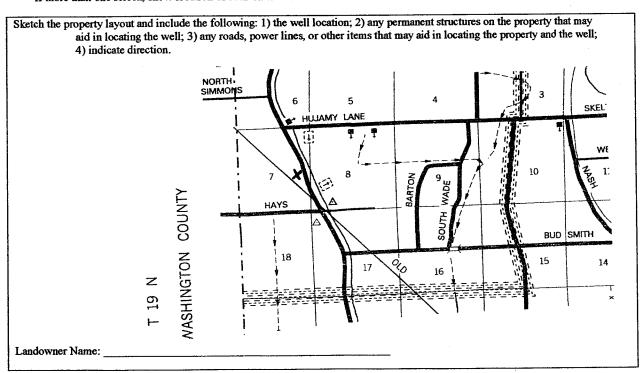

Signature of Water Well Contractor

STATE WELL REPORT

County: Sunflower Permit#: 6 W 4/728 Irrigation Equipment Date: 4-2-07

Part 2
Pump Installer's Completion Report
Mississippi Department of Environmental Quality
Office of Land and Water Resources
P.O. Box 10631
Jackson, MS 39289-0631
(601)961-5210
(601)354-6938 (for)

For Office Use Only:		
Aquifer:		
Well #: M-122		
Elevation:		

(***)534-0938 (IZX)	
This report should be prepared by the pump installer in d installation of pump.	letail and filed with the Department within 30 days of the	
Well Owner Information	Well Location	
Owner Name: McClain Farms	Latitude: Longitude:	
Mailing Address: 164 Hays Road	Method of Lat/Long (circle one): Conventional Survey,	
<u> </u>	USGS quad, Hand-held GPS, Survey-grade GPS	
Indianola MS 38751 City State Zin Code	¼¼ Sec_ 7 Twn 19N Rng 5W	
City State Zip Code	Distance Direction Nearest Town	
Telephone No. ()	6 Miles NW of Indianola	
Pump Type Circle one	Power Type Circle one	
Air Lift Jet Submersible	Diesel Engine Gasoline Engine Natural Gas	
Bucket Piston Turbine	Electric Motor Hand Tractor PTO	
Centrifugal Rotary Flowing Well	Windmill Other (specify):	
Other (specify):	Horse Power Rating of Motor: 25	
Date Pump Installed: 4-4-07	Setting Depth: 70 feet	
Rated Pump Capacity: 1100 Gallons Per Minute	Number of Stages:1	
Pump Test Data	Method of Measuring Water Level	
Date Well Tested:	Circle one	
Static Water Level (A):Feet Below Land Surface	Air Line Electric Measuring Line Steel Tape	
Pumping Water Level (B):Feet Below Land Surface	Other (specify):	
Orawdown [(B) - (A)]:Feet Below Land Surface	For flowing well, measured shut in head:feet	
2 de la constante de la consta		
Test Pumping Rate:Gallons Per Minute	Well yieldedGPM with a drawdown of	

		icc and	nours or pumping
	I HEREBY CERTIFY that the above statements are true to the	e best of my/knowledge./	
İ	Patrick M. Chism 0695	Patris mc	RECEIVED
1	Print Name of Pump Installer and License No. (if applicable)	Signature of Pump Installer	APR 2 4 2007