

State Well Report
Part 1

Mississippi Department of Environmental Quality
Office of Land and Water Resources
P.O. Box 10631
Jackson, MS 39289-0631
(601)961-5210
(601)354-6938 (fax)

County: Sunflower
 Permit #: QW 41863
 Irrigation Equipment
 Driller: _____
 Date drilling completed: 6-23-07

For Office Use Only:
 Aquifer: _____
 Well #: M-123
 L. S. Elevation: _____
 E-log #: _____

State Law requires that this report be prepared by the driller in detail and filed with the Department within 30 days of completion of drilling of the well.

Well Owner Information	Well Location
Owner Name: <u>Fairview Planting</u>	Latitude: <u>33° 31' 30.2"</u> Longitude: <u>90° 45' 14.1"</u>
Mailing Address: <u>594 Fairview Rd</u>	Method of Lat/Long (circle one): <u>30</u> Conventional Survey, <u>19</u>
<u>Indianola Ms. 38751</u>	USGS quad, Hand-held GPS, Survey-grade GPS <u>SE</u> 1/4 <u>NW</u> 1/4 Sec <u>6</u> Twn <u>19N</u> Rng <u>5W</u>
City State Zip Code	Distance Direction Nearest Town <u>7</u> Miles <u>NW</u> of <u>Indianola</u>
Telephone No. () _____	

Well Data

Purpose of Well (circle one) Home Industrial Public Supply Irrigation Fish Culture Other _____

Date well drilling started: 6-23-07 Date well drilling completed: 6-23-07

If flowing, method of flow regulation: Valve _____ Other (describe) _____

Static Water Level: 37 feet above of below (circle one) land surface Date measured: 6-25-07

Method of Measurement (circle one) steel tape electric tape air line other: _____

Hole depth: 126 Well depth: 126 Well grouted to a depth of 10 feet

Type of grout (circle one): Cement Bentonite Mix

Casing length: 86 feet Casing diameter: 10 inches Type of casing: PVC

Screen length: 40 feet Screen diameter: 10 inches Type of screen: PVC

Screen slot size: .050 inches Setting depth: From 87 feet to 126 feet

Type of completion (circle all applicable): Gravel packed Underreamed Telescoped Open hole Natural Development

Other (describe): _____


Top of lap pipe or reduction in casing: _____ feet. If telescoped or more than one screen, describe on back of page

Logs run (circle all applicable): No log run Electric Gamma Ray Density Sonic Neutron Other: _____

Name of organization running log(s): _____

I certify that the well was drilled, constructed, and completed in accordance with all applicable requirements of the Mississippi Department of Environmental Quality and/or the Mississippi Department of Health regulations and state laws.

Irrigation Equipment Inc.
Patrick M. Chism 0695

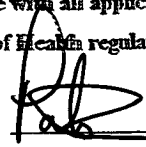
Signature of Water Well Contractor

Print Name of Water Well Contractor and License No.

Signature of Water Well Contractor

RECEIVED

JUL 03 2007
BY: OLWR

STATE WELL REPORT

Part 2

Pump Installer's Completion Report
 Mississippi Department of Environmental Quality
 Office of Land and Water Resources
 P.O. Box 10631
 Jackson, MS 39289-0631
 (601)961-5210
 (601)354-6938 (fax)

County: Sunflower
 Permit #: 6W41863
 Driller: _____
 Date completed: 6-23-07

For Office Use Only:

Acquifer: _____
 Well #: M-123
 Elevation: _____

This report should be prepared by the pump installer in detail and filed with the Department within 30 days of the installation of pump.

Well Owner Information	Well Location
Owner Name: <u>Fairview Planting</u>	Latitude: _____ Longitude: _____
Mailing Address: <u>594 Fairview Rd</u>	Method of Lat/Long (circle one): <input type="radio"/> Conventional Survey,
<u>Indianola Ms. 38751</u>	<input type="radio"/> USGS quad, <input type="radio"/> Hand-held GPS, <input type="radio"/> Survey-grade GPS
City State Zip Code	<u>NE 1/4 NW 1/4 Sec 6 Twn 19N Rng 5W</u>
Telephone No. () _____	Distance Direction Nearest Town
	<u>7 Miles NW of Indianola</u>

Pump Type Circle one	Power Type Circle one
Air Lift <input type="checkbox"/> Jet <input type="checkbox"/> <input checked="" type="checkbox"/> Submersible	Diesel Engine <input type="checkbox"/> Gasoline Engine <input type="checkbox"/> Natural Gas <input type="checkbox"/>
Bucket <input type="checkbox"/> Piston <input type="checkbox"/> Turbine <input type="checkbox"/>	<input checked="" type="checkbox"/> Electric Motor <input type="checkbox"/> Hand <input type="checkbox"/> Tractor PTO
Centrifugal <input type="checkbox"/> Rotary <input type="checkbox"/> Flowing Well <input type="checkbox"/>	Windmill <input type="checkbox"/> Other (specify): _____
Other (specify): _____	Horse Power Rating of Motor: <u>25</u>
Date Pump Installed: <u>6-25-07</u>	Setting Depth: <u>70</u> feet
Rated Pump Capacity: <u>1100±</u> Gallons Per Minute	Number of Stages: <u>1</u>

Pump Test Data	Method of Measuring Water Level Circle one
Date Well Tested: _____	Air Line <input type="checkbox"/> Electric Measuring Line <input type="checkbox"/> Steel Tape <input type="checkbox"/>
Static Water Level (A): _____ Feet Below Land Surface	Other (specify): _____
Pumping Water Level (B): _____ Feet Below Land Surface	For flowing well, measured shut in head: _____ feet
Drawdown [(B) - (A)]: _____ Feet Below Land Surface	Well yielded _____ GPM with a drawdown of _____ feet after _____ hours of pumping
Test Pumping Rate: _____ Gallons Per Minute	
Duration of Pump Test (minimum 4 hours): _____ hours	

I HEREBY CERTIFY that the above statements are true to the best of my knowledge.

Patrick M. Chism 0695 **RECEIVED**
JUL 03 2007

Print Name of Pump Installer and License No. (if applicable) Signature of Pump Installer **BY: OLWR**

6W41863

Fairview Planting Co.

Map R 5 W

RECEIVED


JUL 03 2007

BY: OLWR

M-21 N

- NAVIGATION
- DRIVING
 - RAILROAD
 - THROUGH ROAD
- INDUSTRIAL VILLAGE CENTERS
- VILLAGES
- MISCELLANEOUS
- BOUNDARY
 - ELEVATION
- SERVICE FACILITIES
- WATER OIL
 - ELECTRICITY
 - TELEPHONE CABLE
 - LOOKOUT TOWER
 - PLANT
 - RIVER OR TOWNHALL
 - RAILROAD
 - STATION
- EDUCATION AND RECREATION
- SITE
 - RACE COURSE
 - COUNTRY CLUB
 - INDUSTRIAL
 - TRAIL
- RESOURCES AND CEMETERIES
- ADJACENT
- EDUCATION
- SCHOOL
- MISCELLANEOUS STRUCTURES
- CHURCH

SHAW
 POP. 2,310
 IN BOLIVAR COUNTY
 POP. 2,341
 IN SUNFLOWER COUNTY
 POP. 0

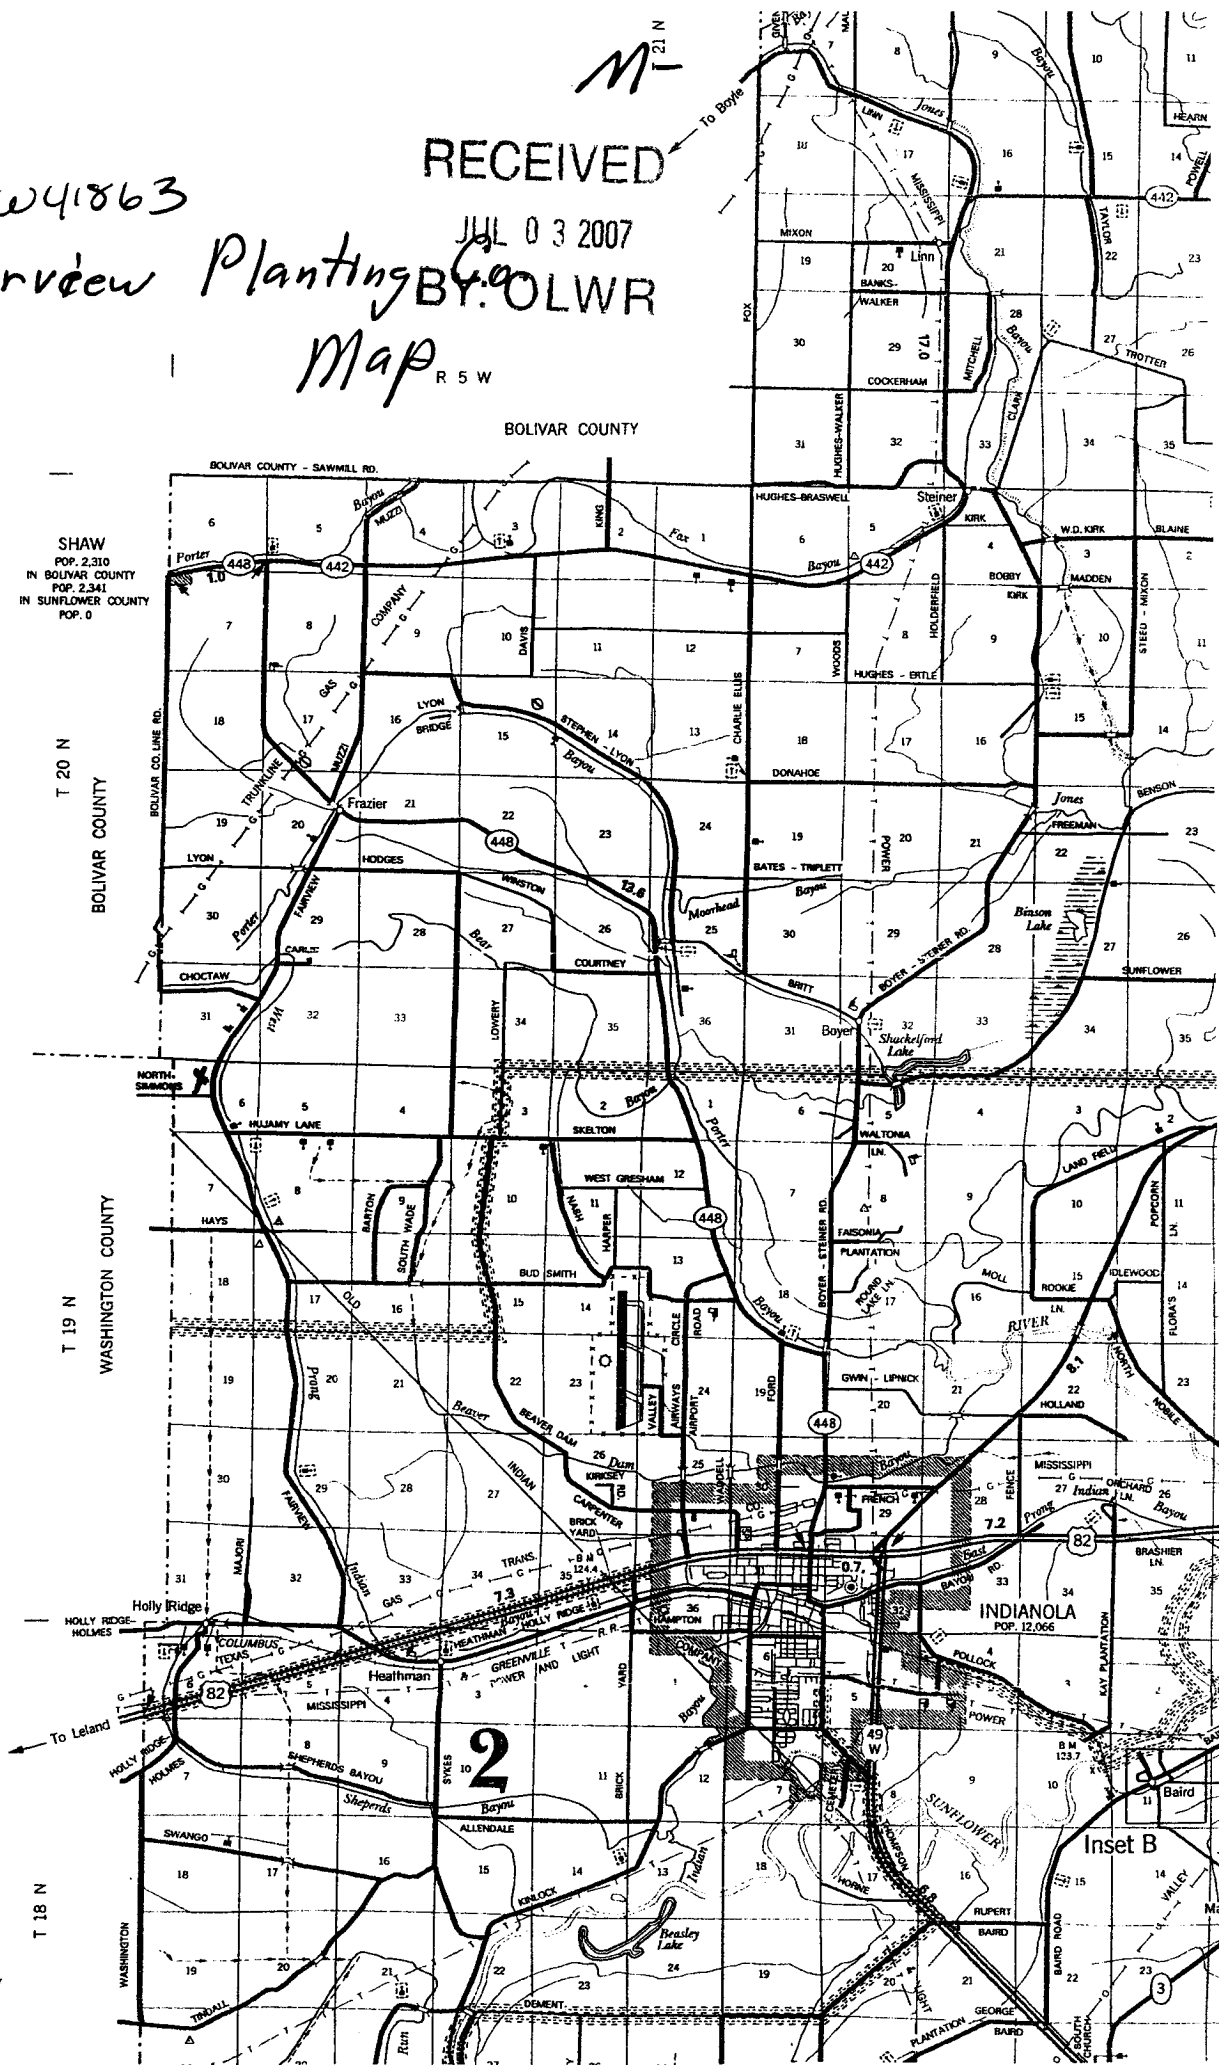

COUNTY

Inset B