

SUNFLOWER

M 2000

7-23-81

MISSISSIPPI BOARD OF WATER COMMISSIONERS 416 North State Street Jackson, Mississippi 39201

WATER WELL DRILLERS LOG

7-23

1981 Scholtz Drilling

Sunflower

date well completed

firm name

county well located

LANDOWNER: FLORA McWhorter

Irvinola MS

description of formations encountered

from

to

Clay

0 21

FINE SAND

21 80

COARSE SAND

80 130

(mailing address)


WELL LOCATION:

sec. 15 T 19 N R 45 E 3 miles NW of Irvinola (distance) (direction) (nearest town)

WELL PURPOSE: HOME (home, irrigation, municipal, industrial)

WELL COMPLETION DATA:


- (1) diameter (inches) 4"
(2) total depth (feet) 130'
(3) static water level (feet) 19 below top of ground.
(4) casing PVC 120' (material) (depth) 4" (size) if telescope see back.
(5) screen 10' (length) 170' (depth to top) 4" (size) PVC WRAPPED (material)
(6) pump 1 hp (HP) 19' (yield gpm) (type power)
(7) electric log NO (yes or no) (organization running log)
(8) how well bottom plugged b/w

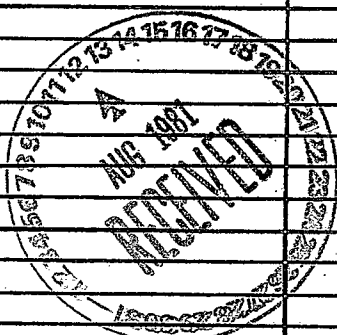

DRILLERS REMARKS:

If well telescopes please sketch and show depths.

GROUND LEVEL

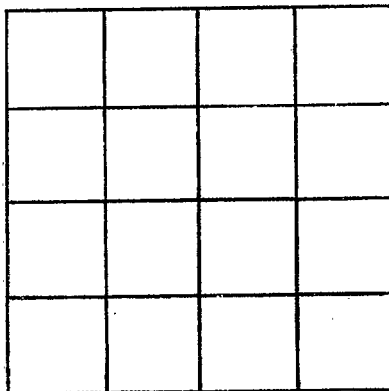

SECTION _____

Please indicate well location X.

ADDITIONAL INFORMATION

If more than one screen, show locations of each on sketch.