

MISSISSIPPI DEPARTMENT OF NATURAL RESOURCES

Bureau of Land and Water Resources

COUNTY WELL LOCATED Sunflower	
WELL NUMBER M 2001	CODED
DATE WELL COMPLETED 1-13-86	

PERMIT NUMBER
NAME OF DRILLING FIRM IRRIGATION Equipment
INDIANOLA, MS

P.O. Box 10631
Jackson, Mississippi 39209
WATER WELL DRILLERS LOG

NAME & MAILING ADDRESS OF LANDOWNER BURKE FISHER			
Rt. 2, BOX 37			
INDIANOLA, MS			
WELL LOCATION: SEC	TOWNSHIP	RANGE	
19	19	5	N S E W
DISTANCE	DIRECTION	NEAREST TOWN	
4 Miles	NORTH	of Holly Ridge	
OTHER LANDMARK			
WELL PURPOSE: Home, Irrigation, Municipal, Industrial, Fish Pond, etc. IRRIGATION			

PUMP DATA		
PUMP TYPE (Circle One): Submersible, <u>Turbine</u> Jet Flowing Well, Other (Describe) _____		
POWER TYPE (Circle One): Electric, Tractor, <u>Diesel</u> Gasoline, Butane, Other (Describe) _____		
Pump Capacity (GPM) 3000	No. of Stages 1	Setting Depth 60 FT.
PUMP TEST		
Well yielded _____ GPM with a drawdown of _____ ft. after _____ hours of pumping		

WELL DATA		
Well Depth 115'	Casing Diameter (In.) 16"	Casing Length (Ft.) 75'
Type of Casing steel	Hole Depth 115'	Depth to Static Water Level 30'
TYPE OF COMPLETION: (Circle One or More): <u>Gravel Packed</u> Underreamed, Telescoped, Natural Development, Open Hole, Other (Describe) _____		
Top of Lap Pipe or Reduction in Casing FEET IF TELESCOPED OR MORE THAN ONE SCREEN: USE BACK PAGE		


LOG DATA	
TYPE OF LOG RUN (Circle One): No Log Run, Electric, Gamma Ray, Density, Sonic, Neutron, Other (Describe) _____	
Name of Organization Running Log	

SCREEN DATA		
Diameter - Inches 16"	Length - Feet 40	Slot Size - Inches 0.060
Screen Type steel wire wrap	Depth to Bottom - Feet 40'	

GEOLOGIC DATA (Office Use Only)			
Surface Elev.	Geologic Unit	Unit Thickness	Depth to Top
Subs. SWL	Date	Analysis	Aquifer Test

Driller's Remarks #86296KSE02 CYPRESS KNEE FARMS
--

DESCRIPTION OF FORMATIONS ENCOUNTERED	FROM	TO
SANDY LOAM	0	10
FINE SAND	10	15
CLAY	15	25
FINE SAND	25	70
COARSE SAND/pea gravel	70	115

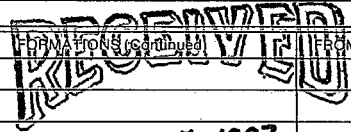

JAN 15 1987

Department of Natural Resources
Bureau of Land & Water Resources

FROM	TO

IF MORE SPACE IS NEEDED, USE BACK

If well telescopes please sketch and show depths.

GROUND LEVEL

IRRIGATION EQUIPMENT
GOL/227-2510
INFLATORS, ETC

	*		

SECTION 19

Please indicate well location X.

ADDITIONAL INFORMATION

If more than one screen,
show location of each on sketch.