

# MISSISSIPPI DEPARTMENT OF NATURAL RESOURCES

Bureau of Land and Water Resources

COUNTY WELL LOCATED <b>Sunflower</b>	
WELL NUMBER <b>M</b>	CODED
DATE WELL COMPLETED <b>2015 7-16-90</b>	

PERMIT NUMBER
NAME OF DRILLING FIRM <b>IRRIGATION EQUIPMENT</b>
<b>601/887-2555</b>

P.O. Box 10631  
Jackson, Mississippi 39209  
WATER WELL DRILLERS LOG

NAME & MAILING ADDRESS OF LANDOWNER <b>James Corder</b>		
<b>208 West Percy</b>		
<b>Indianola, MS</b>		
WELL LOCATION: SEC	TOWNSHIP	RANGE
<b>17</b>	<b>19<sup>N</sup></b>	<b>5<sup>W</sup></b>
DISTANCE	DIRECTION	NEAREST TOWN
<b>4</b> Miles	<b>North</b>	<b>Holly Ridge</b>
OTHER LANDMARK		
WELL PURPOSE: Home, Irrigation, Municipal, Industrial, Fish Pond, etc. <b>IRRIGATION</b>		

PUMP DATA		
PUMP TYPE (Circle One): Submersible, <u>Turbine</u> , Jet, Flowing Well, Other (Describe) _____		
POWER TYPE (Circle One): Electric, Tractor, <u>Diesel</u> , Gasoline, Butane, Other (Describe) _____ H/P <b>30</b>		
Pump Capacity (GPM)	No. of Stages	Setting Depth
<b>1500</b>	<b>2</b>	<b>50</b> FT.
PUMP TEST		
Well yielded _____ GPM with a drawdown of _____ ft. after _____ hours of pumping		

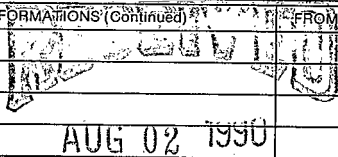
WELL DATA		
Well Depth <b>115</b>	Casing Diameter (In.) <b>10</b>	Casing Length (Ft.) <b>75</b>
Type of Casing <b>PVC</b>	Hole Depth <b>115</b>	Depth to Static Water Level <b>25</b>
TYPE OF COMPLETION: (Circle One or More): <u>Gravel Packed</u> , Underreamed, Telescoped, Natural Development, Open Hole, Other		
Top of Lap Pipe or Reduction in Casing		
FEET IF TELESKOPED OR MORE THAN ONE SCREEN: USE BACK PAGE		

LOG DATA	
TYPE OF LOG RUN (Circle One): Electric, Gamma Ray, Density, Sonic, Neutron, Other (Describe) _____ No Log Run	
Name of Organization Running Log	

SCREEN DATA		
Diameter - Inches <b>10</b>	Length - Feet <b>40</b>	Slot Size - Inches <b>.030</b>
Screen Type <b>PVC</b>	Depth to Bottom - Feet <b>115</b>	

GEOLOGIC DATA (Office Use Only)			
Surface Elev.	Geologic Unit	Unit Thickness	Depth to Top
Subs. SWL	Date	Analysis	Aquifer Test

Driller's Remarks

DESCRIPTION OF FORMATIONS ENCOUNTERED	FROM	TO	FORMATIONS (Continued)	FROM	TO
<b>Clay</b>	<b>0</b>	<b>15</b>			
<b>Fine SAND</b>	<b>15</b>	<b>35</b>			
<b>medium SAND</b>	<b>35</b>	<b>55</b>			
<b>COARSE SAND</b>	<b>55</b>	<b>75</b>			
<b>medium sand</b>	<b>75</b>	<b>85</b>			
<b>COARSE SAND</b>	<b>85</b>	<b>115</b>			

IF MORE SPACE IS NEEDED, USE BACK

If well telescopes please sketch and show depths.

GROUND LEVEL

		X	

SECTION 17

Please indicate well location X.

ADDITIONAL INFORMATION

If more than one screen,  
show location of each on sketch.