

SUNFLOWER

M 2035

3-14-69

MISSISSIPPI
 BOARD OF WATER COMMISSIONERS
 416 North State Street
 Jackson, Mississippi 39201

WATER WELL DRILLERS LOG

CODED

3-14

19 69 DYER WELL TR. SEC

SUNFLOWER

date well completed

firm name

county well located

LANDOWNER: Philip Fratesi

INDIANOLA, Miss.

(mailing address)

WELL LOCATION:

sec 25 T 19 N R 4 E
3 miles N.W. of INDIANOLA
 (distance) (direction) (nearest town)

WELL PURPOSE: FISW
 (home, irrigation, municipal, industrial)

WELL COMPLETION DATA:

- (1) diameter (inches) 10"
- (2) total depth (feet) 105'
- (3) static water level (feet) 18' below above top of ground.
- (4) casing BUC IR, 65'
 (material) (depth)
10' if telescope see back.
 (size)
- (5) screen 40', 65'
 (length) (depth to top)
10", BUC INGOT
 (size) (material)
- (6) pump 28 1500
 (HP) (yield gpm)
BUTANE
 (type power)
- (7) electric log NO
 (yes or no)

(organization running log)

(8) how well bottom plugged PLATE

DRILLERS REMARKS:

description of formations encountered

from

to

CLAY	0	19
BROWN SAND	19	32
COARSE SAND	32	43
FINE SAND	43	63
COARSE SAND & GRAVEL	63	103
CLAY	103	

CODED


CODED

APR 29 1969

MISS. BD. OF WATER COMMISSIONERS

If well telescopes please sketch and show depths.

GROUND LEVEL

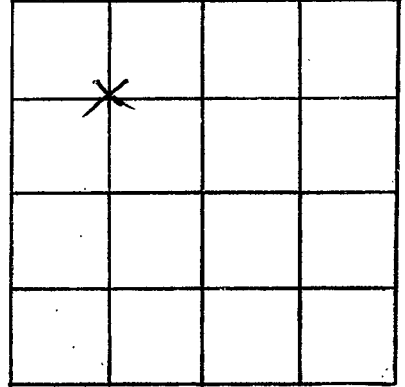

SECTION 25

Please indicate well location X.

ADDITIONAL INFORMATION

If more than one screen,
show locations of each on sketch.