

SUNFLOWER  
 M 2006  
 3-19-69

MISSISSIPPI  
 BOARD OF WATER COMMISSIONERS  
 416 North State Street  
 Jackson, Mississippi 39201

CODED

WATER WELL DRILLERS LOG

3-19 1969 DYER WELL IRR. SER SUNFLOWER  
 date well completed firm name county well located

LANDOWNER: PHILIP FRATES I  
 INDIANOLA, MISS.  
 (mailing address)  
 WELL LOCATION:  
 sec 25 T 19 N R 45 E  
 2 1/2 miles N W of INDIANOLA  
 (distance) (direction) (nearest town)

description of formations encountered	from	to
CLAY	0	22
FINE SAND	22	41
MED. SAND	41	53
FINE SAND	53	63
COARSE SAND & GRAVEL	63	129

WELL PURPOSE: FISH  
 (home, irrigation, municipal, industrial)

WELL COMPLETION DATA:  
 (1) diameter (inches) 16"  
 (2) total depth (feet) 109'  
 (3) static water level (feet) 20' below top of ground.  
 (4) casing BLUE IRON, 69' (material) (depth)  
 16" (size) if telescope see back.  
 (5) screen 40' 69' (length) (depth to top)  
 16" BLUE IRON (size) (material)  
 (6) pump 60 3000 (HP) (yield gpm)  
 BUTANE (type power)  
 (7) electric log NO (yes or no)  
 (organization running log)  
 (8) how well bottom plugged PLATE

CODED


APR 29 1969

MISS. DEPT. OF WATER CONTROL

DRILLERS REMARKS:

If well telescopes please sketch and show depths.

GROUND LEVEL

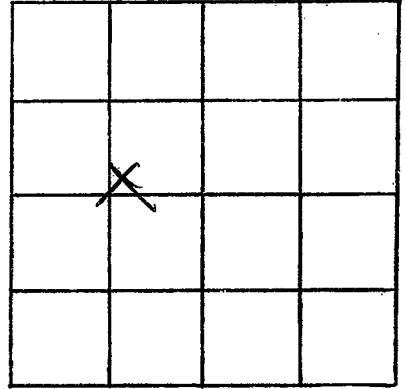

SECTION 25

Please indicate well location X.

ADDITIONAL INFORMATION

If more than one screen, show locations of each on sketch.