

SUNFLOWER

N 24

3-68

MISSISSIPPI  
 BOARD OF WATER COMMISSIONERS  
 416 North State Street  
 Jackson, Mississippi 39201

WATER WELL DRILLERS LOG

MARCH 1 1968 DELTA DRILLING Co. SUNFLOWER  
 date well completed firm name county well located

LANDOWNER: J. H. HILL  
 FAISONIA PLANTATION  
 INDIANOLA, MISS.

INDIANOLA TRACTOR Co.  
 (mailing address)

WELL LOCATION: NW 1/4 NW 1/4  
 sec. 21 T19 N R. 4 E  
 S W  
 2 1/2 miles NE of Indianola  
 (distance) (direction) (nearest town)

WELL PURPOSE: DOMESTIC  
 (home, irrigation, municipal, industrial)

WELL COMPLETION DATA:

- (1) diameter (inches) 4"
- (2) total depth (feet) 1747
- (3) static water level (feet) FLOWING below top of ground.
- (4) casing STEEL, 1747' (material) (depth)  
 4-3+2" (size) if telescope see back.
- (5) screen 20' (length) (depth to top)  
 2" STAINLESS STEEL (size) (material)
- (6) pump (HP) (yield gpm)  
 (type power)
- (7) electric log No - (yes or no)  
 (organization running log)
- (8) how well bottom plugged BACK PRESSURE VALVE


description of fomations encountered	from	to
SAND-	0-	86
gravel	86	149
gumbo	149	210
Shale	210	293
Sand	293	477
gumbo	477	529
Shale	529	547
Sand	547	643
gumbo	643	682
Shale	682	732
Sand	732	864
Shale	864	904
gumbo	904	945
green Shale	945	970
green Sand	970	1009
gumbo	1009	1030
green Sand w/rocks	1030	1090
green Shale w/rocks	1090	1165
green Sand w/rocks	1165	1287
green Shale w/rocks	1287	1321
green Sand w/rocks	1321	1412
gumbo	1412	1424
green Sand w/rocks	1424	1480
Shale w/rocks	1480	1512
green Sand w/rocks	1512	1540
gumbo	1540	1565
Shale	1565	1580
Sand	1580	1640
Shale	1640	1670
Sand	1670	1744
Shale	1744	1747

MAY 28 1968  
 MISS. BD OF WATER COMMISSIONERS

DRILLERS REMARKS:

Per July 8-68

If well telescopes please sketch and show depths.

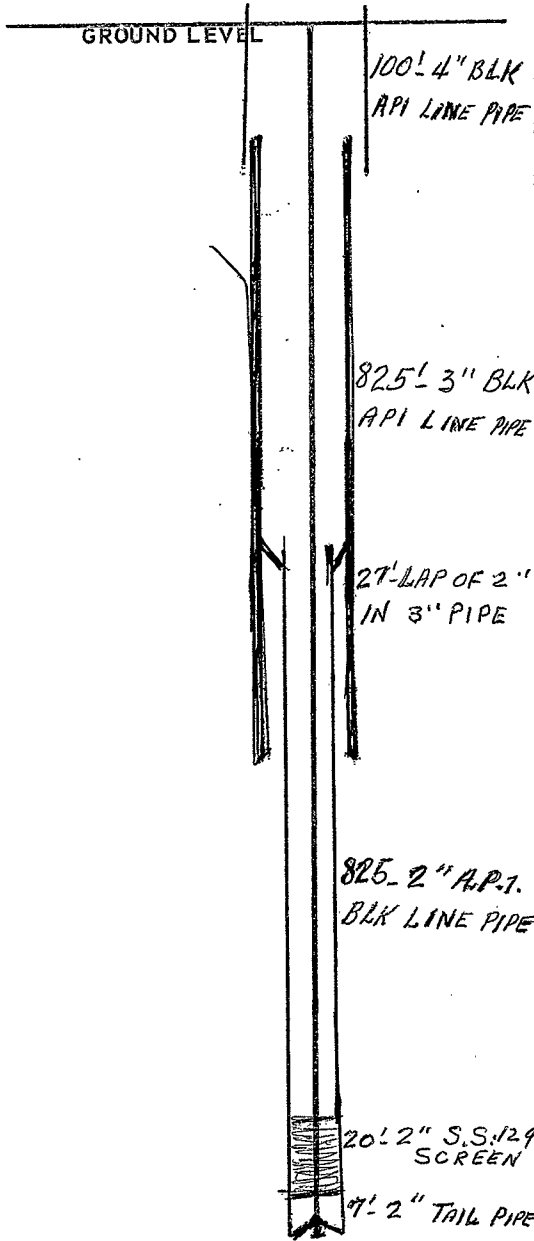


SECTION \_\_\_\_\_

Please indicate well location X.

ADDITIONAL INFORMATION

If more than one screen,  
show locations of each on sketch.