

MISSISSIPPI  
BOARD OF WATER COMMISSIONERS  
416 North State Street  
Jackson, Mississippi 39201

WATER WELL DRILLERS LOG

123 ft L.S.  
(log header)

Sunflower  
N 25  
2-68  
Elec Log  
2-9  
date well completed

1968 Leyne-Central Company Sunflower  
firm name county well located

LANDOWNER: City of Indianola, Miss.  
  
(mailing address)  
  
WELL LOCATION: Park & Breaker St.  
sec. 31 T 19 N R 4 E  
NE, NW, SE  
miles of (distance) (direction) (nearest town)


description of formations encountered	from	to
Soil	0	1
Clay	1	15
Medium Sand	15	50
Coarse Sand	50	75
Coarse Sand & Fine Gravel	75	105
Gravel	105	158
Sand & streaks of clay	158	210
Clay	210	226
Sand & streaks of clay	226	286
Clay	286	310
Sand & streaks of clay	310	590
Shale	590	675
Sandy Shale	675	695
Shale	695	707
Hard Rock	707	708
Sandy Shale	708	810
Shale	810	875
Sandy Shale	875	996
Hard Shale	996	1108
Rock	1108	1109
Shale	1109	1120
Rock	1120	1121
Hard Shale	1121	1168
Rock	1168	1169
Hard Shale	1169	1189
Rock	1189	1190
Shale	1190	1242
Rock	1242	1243
Shale	1243	1248
Rock	1248	1249
Sandy Shale	1249	1376
Hard Shale	1376	1385
Sandy Shale	1385	1408
Rock	1408	1409
Sandy Shale & streaks of Rock	1409	1471
Sand & streaks of Rock	1471	1575
Sandy Shale & Shale Rock	1575	1664
Timber Sand	1664	1697
Sand	1697	1758
Shale	1758	1778

WELL PURPOSE: Municipal  
(home, irrigation, municipal, industrial)


WELL COMPLETION DATA:  
 (1) diameter (inches) 12"  
 (2) total depth (feet) 1761'  
 (3) static water level (feet) 29' below top of ground.  
 (4) casing Steel, 1688' (material) (depth)  
12" if telescope see back. (size)  
 (5) screen 60', 1695' (length) (depth to top)  
8", Stainless Steel (size) (material)  
 (6) pump 75 (HP) (yield gpm)  
Electric (type power)  
 (7) electric log Yes (yes or no)  
U.S.G.S. (organization running log)  
 (8) how well bottom plugged Value

DRILLERS REMARKS:  
Pump not installed, as of this date - no test  
drill

If well telescopes please sketch and show depths.

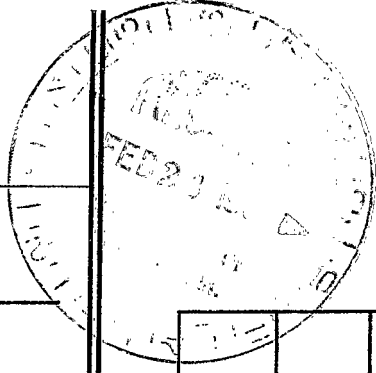

GROUND LEVEL

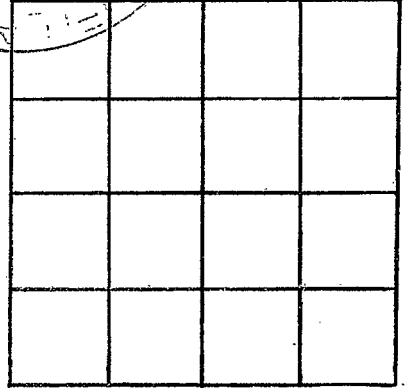

SECTION 31

Please indicate well location X.

ADDITIONAL INFORMATION

A series of horizontal lines for writing additional information, starting below the 'ADDITIONAL INFORMATION' header and extending to the bottom of the page.

If more than one screen, show locations of each on sketch.