

Sunflower
 N 26
 6-67

MISSISSIPPI
 BOARD OF WATER COMMISSIONERS
 416 North State Street
 Jackson, Mississippi 39201

WATER WELL DRILLERS LOG

June 5-67 19 Botone Gas of Greenwood Sunflower
 date well completed firm name county well located

LANDOWNER:
 J. H. Hill
 Indianola
 (mailing address)

description of formations encountered	from	to
Clay	1	10
RED SAND	10	30
Coarse Sand & Gravel	30	24

WELL LOCATION:
 sec. 8 T. 19 N R. 4 E
 3 miles N of Indianola
 (distance) (direction) (nearest town)

WELL PURPOSE: Domestic
 (home, irrigation, municipal, industrial)

WELL COMPLETION DATA:

(1) diameter (inches) 4"

(2) total depth (feet) 94'

(3) static water level (feet) 15 below top of ground.

(4) STEEL 4" casing (material), 84' (depth), 4" (size) if telescope see back.


(5) screen 10' (length), 84' (depth to top), 4" (size), STAINLESS STEEL (material)

(6) pump 2 (HP), 25 (yield gpm), Electric (type power)

(7) electric log No (yes or no)

(organization running log)


(8) how well bottom plugged Back Pressure Valve

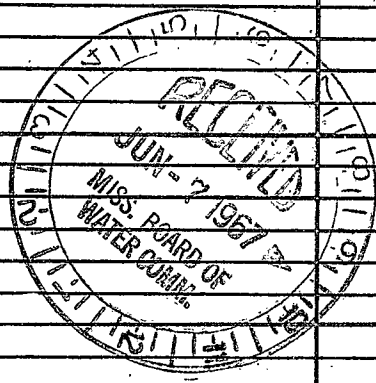

DRILLERS REMARKS:

If well telescopes please sketch and show depths.

GROUND LEVEL

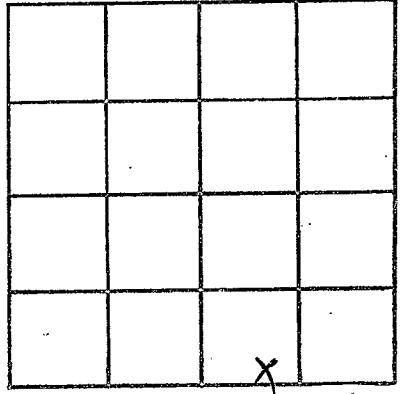

SECTION 8

Please indicate well location X.

ADDITIONAL INFORMATION

If more than one screen,
show locations of each on sketch.