

Sunflower  
N 27  
3-67

MISSISSIPPI  
BOARD OF WATER COMMISSIONERS  
416 North State Street  
Jackson, Mississippi 39201

WATER WELL DRILLERS LOG

7-17-1967 date well completed      1967 Five Counties Services firm name      Sunflower county well located

LANDOWNER: HT WATSON

description of formations encountered      from      to

Luxington Miss (mailing address)


1/2 sand & clay      27'  
sand, gravel & clay      83' 110'  
gravel      21' 131'

WELL LOCATION:  
sec. 17 T. 14 N. S. R. 4 E. W.  
2 miles S of Sunflower (distance) (direction) (nearest town)

WELL PURPOSE: irrigation (home, irrigation, municipal, industrial)

WELL COMPLETION DATA:

- (1) diameter (inches) 6"
- (2) total depth (feet) 104' 10"
- (3) static water level (feet) 22' 8" below top of ground.
- (4) casing 6" 800 pipe 56' 10" (material) (depth)
- 6 3/8" (size) if telescope see back.
- (5) screen 48' 56' (length) (depth to top)
- 6" steel (size) (material)
- (6) pump 30 1500 (HP) (yield gpm)
- Inverter (type power)
- (7) electric log NO (yes or no)
- (organization running log)
- (8) how well bottom plugged steel

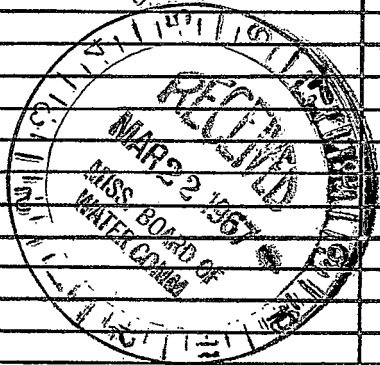

Handwritten notes: 12 1/2' / 10' / 12' / 12'

DRILLERS REMARKS:

If well telescopes please sketch and show depths.

GROUND LEVEL

		X	

SECTION 12

Please indicate well location X.

ADDITIONAL INFORMATION

If more than one screen, show locations of each on sketch.