

Sunflower

N 28

MISSISSIPPI BOARD OF WATER COMMISSIONERS

11-66

WATER WELL DRILLERS LOG

Date: 11-30, 1966, Driller: Butane Gas Co. County: Sunflower (Name)

(1) Owner of Land: J.R. Stinson (Name)

Moorehead, Miss. (Address)

(2) Location: SE 1/4, SW 1/4, Sec 36 T19R4 N W

4 miles W of Moorehead (distance) (direction) (Nearest Town)

(3) Topography: (Hilly) (Flat) (Level) [Level checked]

(4) Purpose of Well: Irrigation (Domestic Irrigation, Municipal, Industrial, Other)

Description & Color of Materials Sand, Clay, Red Clay, Shell, etc.	Thick- ness Feet	Depth Feet
Clay	35	35
Sand + Gravel		93

Information upon completion of well:

(1) Diameter 12 inches.

(2) Total Depth 93 feet.

(3) Water Level 25' feet below top of ground.

(4) Cased to 93, Size 12"

(5) Screen: Size 12", Length 40'


(6) Were any formations sealed against pollution?

yes, no. [yes checked]

If YES depth of formation

Why

Drillers Remarks:

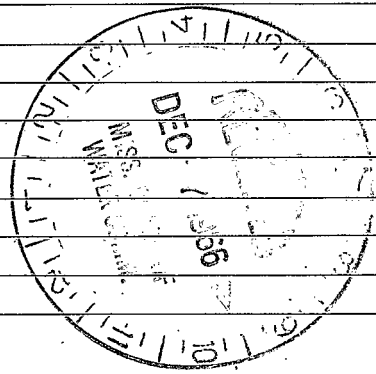

(Use Back Side)

Well No.

