

N
11-66 29

WATER WELL DRILLERS LOG

GW 4556
NE/NW, Sec. 9

Date: 11-23, 1966, Driller: Butam Gas Co. County Sunflower
Elev. —
(Name)


(1) Owner of Land: <u>J. H. Hill</u> (Name)	Description & Color of Materials Sand, Clay, Red Clay, Shell, etc.	Thick- ness Feet	Depth Feet
<u>Indianola, Miss.</u> (Address)	<u>Clay</u>	<u>18</u>	<u>18</u>
(2) Location: <u>NE 1/4, NE 1/4, Sec. 9 T94N</u> <u>4</u> miles <u>N</u> , of <u>Indianola</u> (distance) (direction) (Nearest Town)	<u>Sand</u>		<u>40</u>
	<u>Sand + Gravel</u>		<u>103</u>
(3) Topography: <u>X</u> (Hilly) (Flat) (Level)			
(4) Purpose of Well: <u>Irrigation</u> (Domestic Irrigation Municipal, Industrial, Other)			

Information upon completion of well:

- (1) Diameter 16 inches.
- (2) Total Depth 103 feet.
- (3) Water Level 18 feet below top of ground.
- (4) Cased to 100, Size 16.
- (5) Screen: Size 16", Length 40".
- (6) Were any formations sealed against pollution?
_____ yes, X no.

If YES depth of formation _____
Why _____

Drillers Remarks: _____

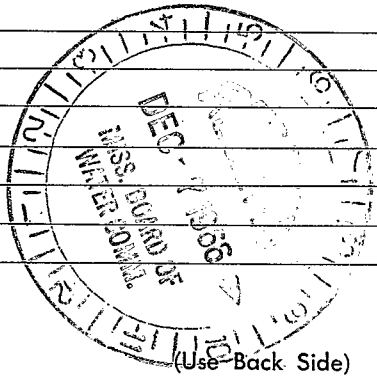

Well No.

