

SUNF.


N 30

12-7-62

WATER WELL DRILLERS LOG

Date: DEC. 7, 1962, Driller: DELTA DRILLING Co. County SUNFLOWER  
 (Name)

	Description & Color of Materials Sand, Clay, Red Clay, Shell, etc.	Thick- ness Feet	Depth Feet
(1) Owner of Land: <u>NICK DECLEMENT</u> (Name) <u>INDIANOLA, MISS</u> (Address)	SAND	94	94
(2) Location: <u>SW 1/4, SW 1/4, Sec. 25 T12N R4 W</u> _____ miles _____ of _____ (distance) (direction) (Nearest Town)	GRAVEL	88	182
(3) Topography: _____ (Hilly) (Flat) (Level)	SAND	60	242
(4) Purpose of Well: <u>DOMESTIC</u> (Domestic Irrigation Municipal, Industrial, Other)	GUMBO	11	253
Information upon completion of well:	SAND	148	401
(1) Diameter <u>3</u> inches.	GUMBO	17	418
(2) Total Depth <u>1638</u> feet.	SAND w/ROCKS-	102	520
(3) Water Level <u>WELL FLOWS</u> feet below top of ground.	GUMBO w/ROCKS-	46	666
(4) Cased to <u>1608</u> , Size <u>2"-814</u> , <sup>3"-820'</sup>	SHALE	20	686
(5) Screen: Size <u>2"</u> , Length <u>30'</u>	GUMBO	15	701
(6) Were any formations sealed against pollution? _____ yes, _____ no.	SAND	47	748
If YES, depth of formation _____	SHALE	40	788
Why _____	SAND	20	808
Drillers Remarks: <u>WELL FLOWS 75GPM</u> <u>26' LAP OF 2" IN 3" PIPE.</u>	GUMBO	30	838
	SHALE	60	898
	SAND	20	918
	GUMBO w/ROCKS	82	1000
	SHALE w/ROCKS	60	1060
	GREEN SAND w/ROCKS	140	1200
	SHALE	90	1290
	GREEN SAND w/ROCKS	86	1376
	GUMBO	79	1455
	SAND	27	1482
	GUMBO	25	1507
	SHALE	52	1559
	SAND	79	1638

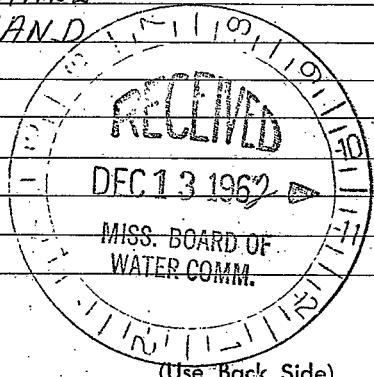

(Use Back Side)

Well No.

