


N 31

WATER WELL DRILLERS LOG

12-20-62

Date: DEC. 20, 1962, Driller: DELTA DRILLING Co County: SUNFLOWER  
(Name)

		Description & Color of Materials Sand, Clay, Red Clay, Shell, etc.	Thick- ness Feet	Depth Feet
(1) Owner of Land: <u>E. W. WILLIAMS</u> (Name)		<u>GUMBO</u>	<u>24</u>	<u>24</u>
<u>INDIANOLA, MISS.</u> (Address)		<u>SAND</u>	<u>40</u>	<u>64</u>
(2) Location: <u>SE 1/4, NW 1/4, Sec. 14 T19R4W</u>		<u>GRAVEL</u>	<u>84</u>	<u>148</u>
_____ miles _____ of _____ (distance) (direction) (Nearest Town)		<u>GUMBO</u>	<u>74</u>	<u>222</u>
(3) Topography: _____ (Hilly) (Flat) (Level)		<u>SAND</u>	<u>114</u>	<u>336</u>
(4) Purpose of Well: <u>DOMESTIC</u> (Domestic Irrigation Municipal, Industrial, Other)		<u>GUMBO</u>	<u>52</u>	<u>388</u>
Information upon completion of well:		<u>SAND</u>	<u>20</u>	<u>408</u>
(1) Diameter: <u>3</u> inches.		<u>GUMBO</u>	<u>15</u>	<u>423</u>
(2) Total Depth: <u>1640</u> feet.		<u>SAND</u>	<u>16</u>	<u>439</u>
(3) Water Level: <u>WELL FLOWS</u> feet below top of ground.		<u>GUMBO</u>	<u>120</u>	<u>559</u>
(4) Cased to: <u>1610</u> , Size <u>725'-2"</u>	<u>900'-3"</u>	<u>SAND</u>	<u>30</u>	<u>589</u>
(5) Screen: Size <u>2"</u> , Length <u>30</u>		<u>GUMBO</u>	<u>68</u>	<u>657</u>
(6) Were any formations sealed against pollution? _____ yes, _____ no.		<u>SAND</u>	<u>82</u>	<u>739</u>
If YES depth of formation _____		<u>GUMBO</u>		<u>21760</u>
Why _____		<u>SAND</u>		<u>32792</u>
Drillers Remarks: <u>15' LAP OF 2" IN 3" PIPE</u>		<u>GUMBO W/ROCKS -</u>		<u>157943</u>
		<u>SHALE</u>		<u>15958</u>
		<u>SAND W/ROCKS -</u>		<u>35993</u>
		<u>SHALE</u>		<u>301023</u>
		<u>SAND W/ROCKS</u>		<u>321055</u>
		<u>SHALE</u>		<u>121067</u>
		<u>GREEN SAND W/ROCKS</u>		<u>661133</u>
		<u>SHALE W/8" ROCK -</u>		<u>611194</u>
		<u>GUMBO</u>		<u>291223</u>
		<u>SAND</u>		<u>361259</u>
		<u>SHALE W/ROCKS -</u>		<u>841343</u>
		<u>SAND</u>		<u>901433</u>
		<u>SHALE</u>		<u>651498</u>
		<u>SAND</u>		<u>1161614</u>
		<u>SHALE</u>		<u>8201634</u>
		<u>GUMBO</u>		<u>161640</u>

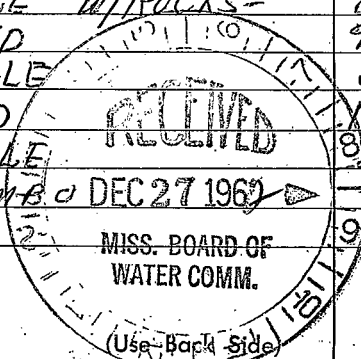

Well No.

