

GW 4641  
SE/NW, Sec. 23  
Eleu. —

Sunflower  
N 32

MISSISSIPPI BOARD OF WATER COMMISSIONERS

WATER WELL DRILLERS LOG

Date: 8/15, 19 66, Driller: Butane Gas Co. County Sunflower  
(Name)

(1) Owner of Land: G. C. Scroggins  
(Name)  
Baird, Miss.  
(Address)

(2) Location: SE SE 13 19N W  
1/4, 1/4, Sec. 13 T R  
4 miles NE, of Indianola,  
(distance) (direction) (Nearest Town)

(3) Topography: Flat  
(Hilly) (Flat) (Level)

(4) Purpose of Well: Irrigation  
(Domestic Irrigation  
Municipal, Industrial, Other)

| Description & Color of Materials<br>Sand, Clay, Red Clay, Shell, etc. | Thick-<br>ness<br>Feet | Depth<br>Feet |
|---|------------------------|---------------|
| Clay  | 13                     | 13            |
| "   | 10                     | 23            |
| "   | 10                     | 33            |
| Fine Sand   | 10                     | 43            |
| " "   | 10                     | 53            |
| Coarse Sand-Gravel  | 10                     | 63            |
| " " "   | 10                     | 73            |
| " " "   | 10                     | 83            |
| " " "   | 10                     | 93            |


Information upon completion of well:

- (1) Diameter 16 inches.
- (2) Total Depth 93 feet.
- (3) Water Level 21 feet below top of ground.
- (4) Cased to 53, Size 16
- (5) Screen: Size 16, Length 40
- (6) Were any formations sealed against pollution?  
yes, X no.

If YES depth of formation \_\_\_\_\_

Why \_\_\_\_\_

Drillers Remarks: \_\_\_\_\_

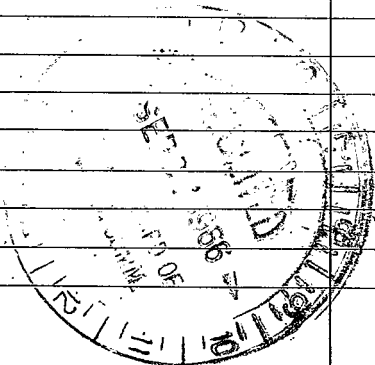

(Use Back Side)

Well No.

Retain this copy for your office files.

