

SUNFLOWER

N 39

10/25/80

MISSISSIPPI BOARD OF WATER COMMISSIONERS
416 North State Street
Jackson, Mississippi 39201

CODED

WATER WELL DRILLERS LOG

SEPT 25

date well completed

1980 BUTANE GAS COMPANY
OF GREENWOOD

SUNFLOWER

county well located

LANDOWNER: FERRAC & BARNWELL

description of formations encountered

from

to

Indianola, MS
(mailing address)

CLAY 0 18
SAND 18 60
SAND & GRAVEL 60 105

WELL LOCATION:

sec 28 T 19 N R 4 E
S W
1 miles North of Indianola
(distance) (direction) (nearest town)

CODED

WELL PURPOSE: INDUSTRIAL
(home, irrigation, municipal, industrial)

WELL COMPLETION DATA:

- (1) diameter (inches) 4"
- (2) total depth (feet) 103'
- (3) static water level (feet) _____ below above top of ground.
- (4) casing PVC 73' (material) (depth)
- (size) if telescope see back.
- (5) screen 30' 73' (length) (depth to top)
- 4" PVC (size) (material)
- (6) pump 1 20 (HP) (yield gpm)
- ELECTRIC (type power)
- (7) electric log No (yes or no)
- No (organization running log)
- (8) how well bottom plugged BACK PRESSURE VALVE

DEPT. OF NATURAL RESOURCES
BUREAU OF LAND & WATER RESOURCES

OCT 10 1980


RECEIVED

DRILLERS REMARKS:

✓

If well telescopes please sketch and show depths.

GROUND LEVEL

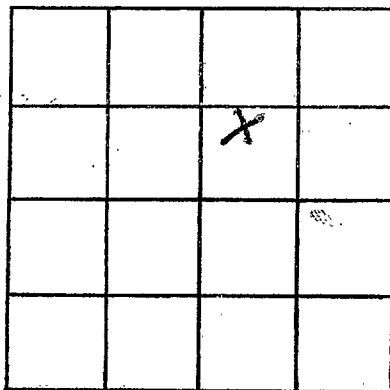

SECTION 28

Please indicate well location X.

ADDITIONAL INFORMATION

If more than one screen,
show locations of each on sketch.