

**MISSISSIPPI DEPARTMENT OF NATURAL RESOURCES**  
 Bureau of Land and Water Resources  
 Southport Mall  
 P.O. Box 10631 **CODED**  
 Jackson, Mississippi 39209  
**WATER WELL DRILLERS LOG**

**SUNFLOWER**  
**N40**  
**4-24-81**

4-24-81 19 BUTANE GAS CO. OF GREENWOOD Sunflower  
 date well completed firm name county well located

**LANDOWNER:**  
Seymour Johnson  
Indianola  
 (mailing address)

**WELL LOCATION:**  
 sec. 35 T 7 N R 4 W  
3 miles SE of Indianola  
 (distance) (direction) (nearest town)

| description of formations encountered | from | to |
|---------------------------------------|------|----|
| Clay                                  | 0    | 20 |
| Clay + Fine Sand                      | 20   | 30 |
| Fine Sand                             | 30   | 40 |
| Coarse Sand                           | 40   | 70 |
| Sand + Gravel                         | 70   | 98 |
| Clay                                  |      |    |

**WELL PURPOSE:** FR.  
 (home, irrigation, municipal, industrial)

**WELL COMPLETION DATA:**

(1) diameter (inches) 16"

(2) total depth (feet) 98

(3) static water level (feet) 30 below above top of ground.

(4) casing Steel, 58',  
 (material) (depth)  
16" if telescope see back.  
 (size)


(5) screen 40', 58'  
 (length) (depth to top)  
16", Steel  
 (size) (material)

(6) pump 50 2400  
 (HP) (yield gpm)  
Electric  
 (type power)

(7) electric log No  
 (yes or no)

(organization running log)

(8) how well bottom plugged Steel Plate

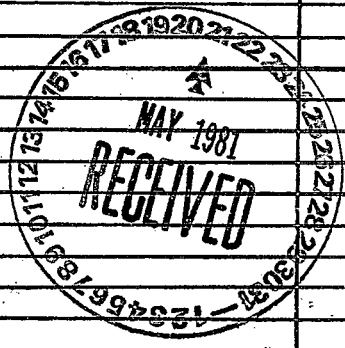

**DRILLERS REMARKS:**

If well telescopes please sketch and show depths.

GROUND LEVEL

|   |  |  |  |
|---|--|--|--|
|   |  |  |  |
|   |  |  |  |
|   |  |  |  |
| X |  |  |  |

SECTION 35

Please indicate well location X.

ADDITIONAL INFORMATION

If more than one screen, show locations of each on sketch.