

GW

Sunflower
N41
2-22-80

MISSISSIPPI
BOARD OF WATER COMMISSIONERS
416 North State Street
Jackson, Mississippi 39201

CODED

WATER WELL DRILLERS LOG

2/22 1980 Dyer Sunflower
date well completed firm name county well located

LANDOWNER:
WATSON & WATSON
Sunflower, MS.
(mailing address)


description of formations encountered	from to	
	from	to
<u>Clay</u>	<u>0</u>	<u>28</u>
<u>fine sand</u>	<u>28</u>	<u>35</u>
<u>sand</u>	<u>35</u>	<u>48</u>
<u>sand & gravel</u>	<u>48</u>	<u>110</u>

WELL LOCATION:
sec. 14 T. 19D N. R. 4 E.
3 miles SW of Sunflower
(distance) (direction) (nearest town)

WELL PURPOSE: 2)
(home, irrigation, municipal, industrial)

- WELL COMPLETION DATA:
- (1) diameter (inches) 16"
 - (2) total depth (feet) 110'
 - (3) static water level (feet) 20' below top of ground.
 - (4) casing Steel 110'
(material) (depth)
 - 16" if telescope see back.
(size)
 - (5) screen 40' 20'
(length) (depth to top)
 - 16" Steel
(size) (material)
 - (6) pump 60 3000
(HP) (yield gpm)
 - Diesel
(type power)
 - (7) electric log _____
(yes or no)
 - _____
(organization running log)
 - (8) how well bottom plugged plate


CODED

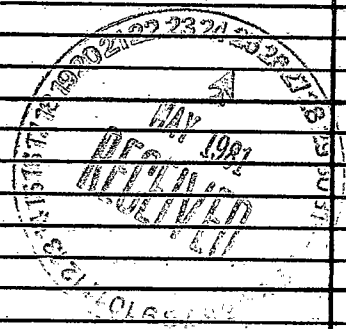

DRILLERS REMARKS:

If well telescopes please sketch and show depths.

GROUND LEVEL

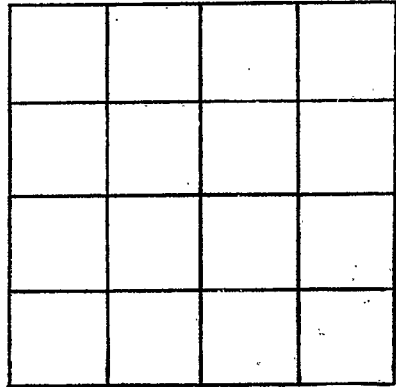

SECTION _____

Please indicate well location X.

ADDITIONAL INFORMATION

If more than one screen,
show locations of each on sketch.