

MISSISSIPPI DEPARTMENT OF NATURAL RESOURCES

Bureau of Land and Water Resources

Southport Mall

P.O. Box 10631

Jackson, Mississippi 39209

CODED

WATER WELL DRILLERS LOG

Sun Flower
N42
2-25-81

Feb 25 1981
 date well completed

Larry's well & pump
 firm name

Sunflower
 county well located

LANDOWNER:	description of formations encountered	from	to
<u>Delta Fish</u>	<u>slay</u>	<u>0</u>	<u>18</u>
<u>Indianola MS</u> (mailing address)	<u>Burned Sand</u>	<u>18</u>	<u>30</u>
WELL LOCATION:	<u>Heavy med Sand</u>	<u>30</u>	<u>50</u>
sec. <u>32</u> T. <u>18</u> N. R. <u>4</u> E	<u>stare sand</u>	<u>50</u>	<u>100</u>
<u>1</u> miles <u>SE</u> of <u>Indianola</u>	<u>coarse sand & gravel</u>	<u>100</u>	<u>130</u>
(distance) (direction) (nearest town)	<u>slay</u>	<u>130</u>	<u>220</u>
WELL PURPOSE: <u>Fish</u> (home, irrigation, municipal, industrial)	<u>sand</u>	<u>220</u>	<u>350</u>
WELL COMPLETION DATA: <u>2000-64</u>	<u>slay & sand streaks</u>	<u>350</u>	<u>550</u>
(1) diameter (inches) <u>6" x 4"</u>	<u>slay</u>	<u>550</u>	<u>680</u>
(2) total depth (feet) <u>808'</u>	<u>sand</u>	<u>680</u>	<u>808</u>
(3) static water level (feet) <u>20</u> below top of ground.			
(4) casing <u>steel</u> , <u>728</u> , (material) (depth) (size) if telescope see back.			
(5) screen <u>80</u> , <u>728</u> (length) (depth to top) <u>4"</u> , <u>stainless</u> (size) (material)			
(6) pump <u>20</u> , <u>250</u> (HP) (yield gpm) <u>Electric</u> (type power)			
(7) electric log _____ (yes or no) (organization running log)			
(8) how well bottom plugged _____			
DRILLERS REMARKS:			

CODED


DEPT. OF NATURAL RESOURCES
 BUREAU OF LAND & WATER RESOURCES

JUN 3 - 1981

RECEIVED

If well telescopes please sketch and show depths.

GROUND LEVEL

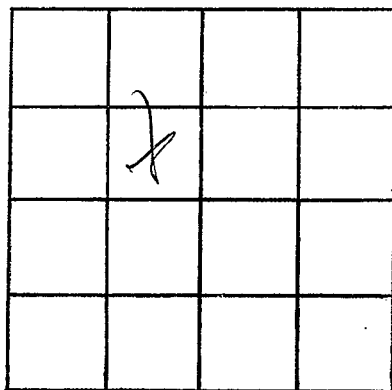

SECTION 33

Please indicate well location X.

ADDITIONAL INFORMATION

If more than one screen,
show locations of each on sketch.